


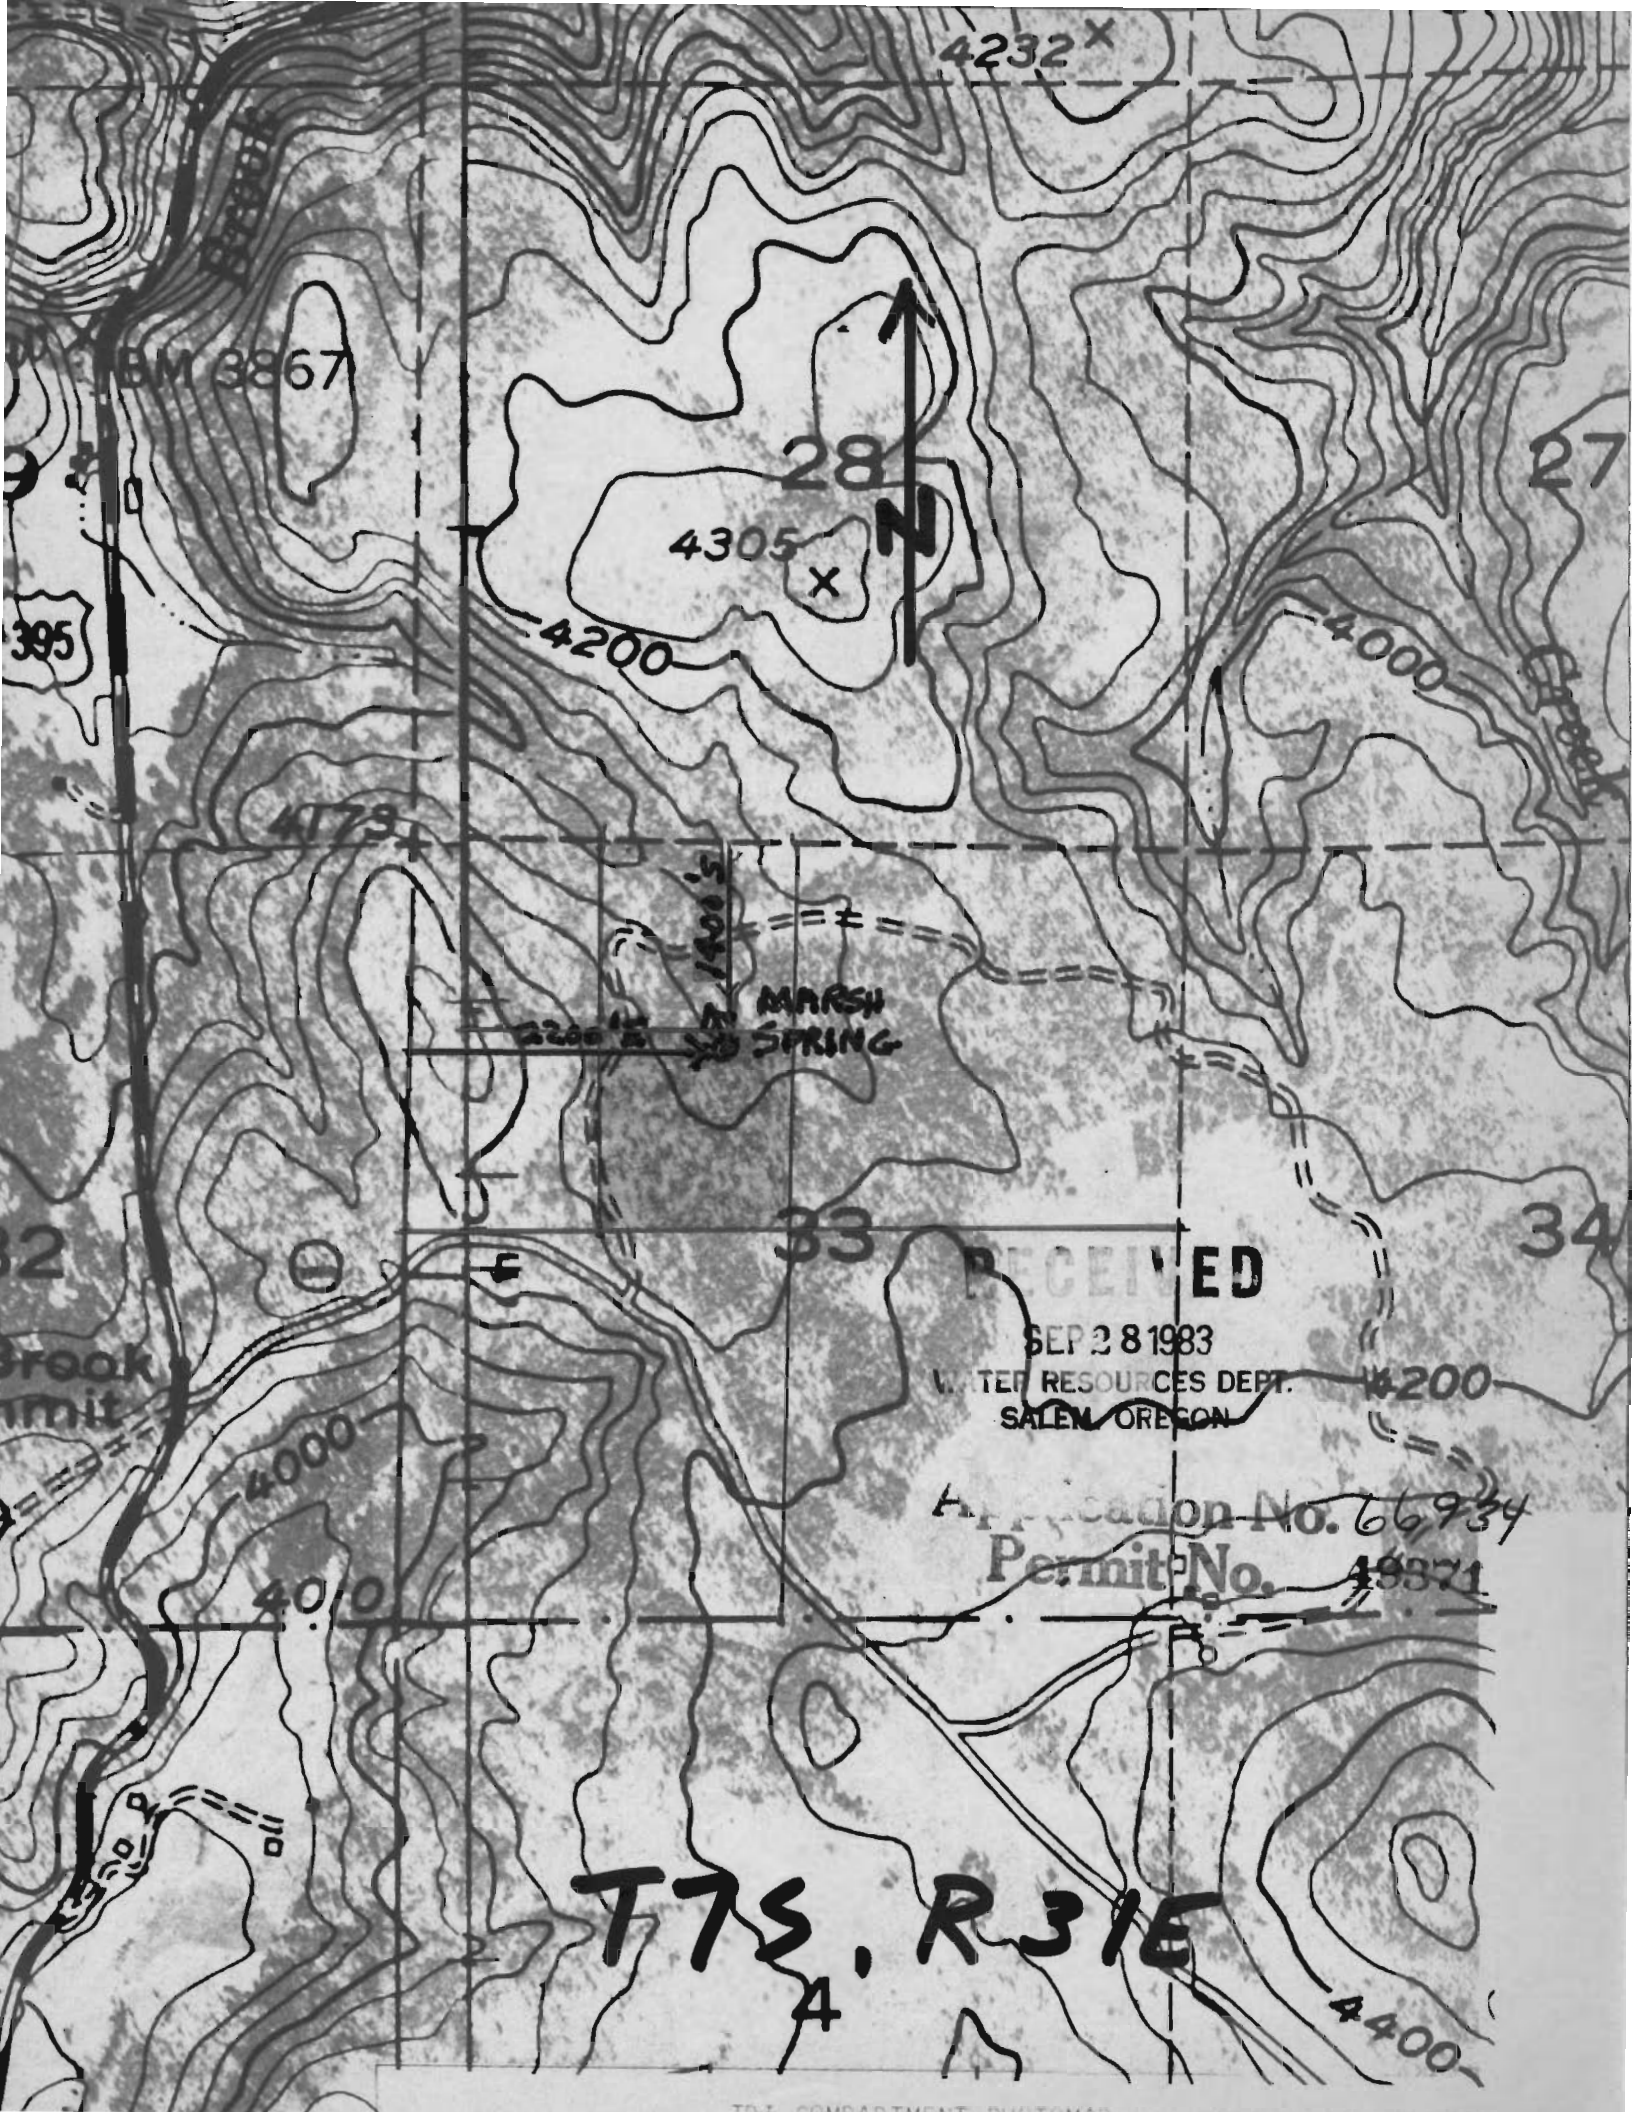

4232 X

BM 3867

28
4305 X

27

4200

4000

4173

1400'S

MARSH SPRING

2200'S

33

RECEIVED

SEP 28 1983

WATER RESOURCES DEPT.
SALEM OREGON

34

4200

Application No. 66934

Permit No. 49371

4000

T7S, R31E

4

4400