
T13S R1E Sec 5 NW¼ NW¼

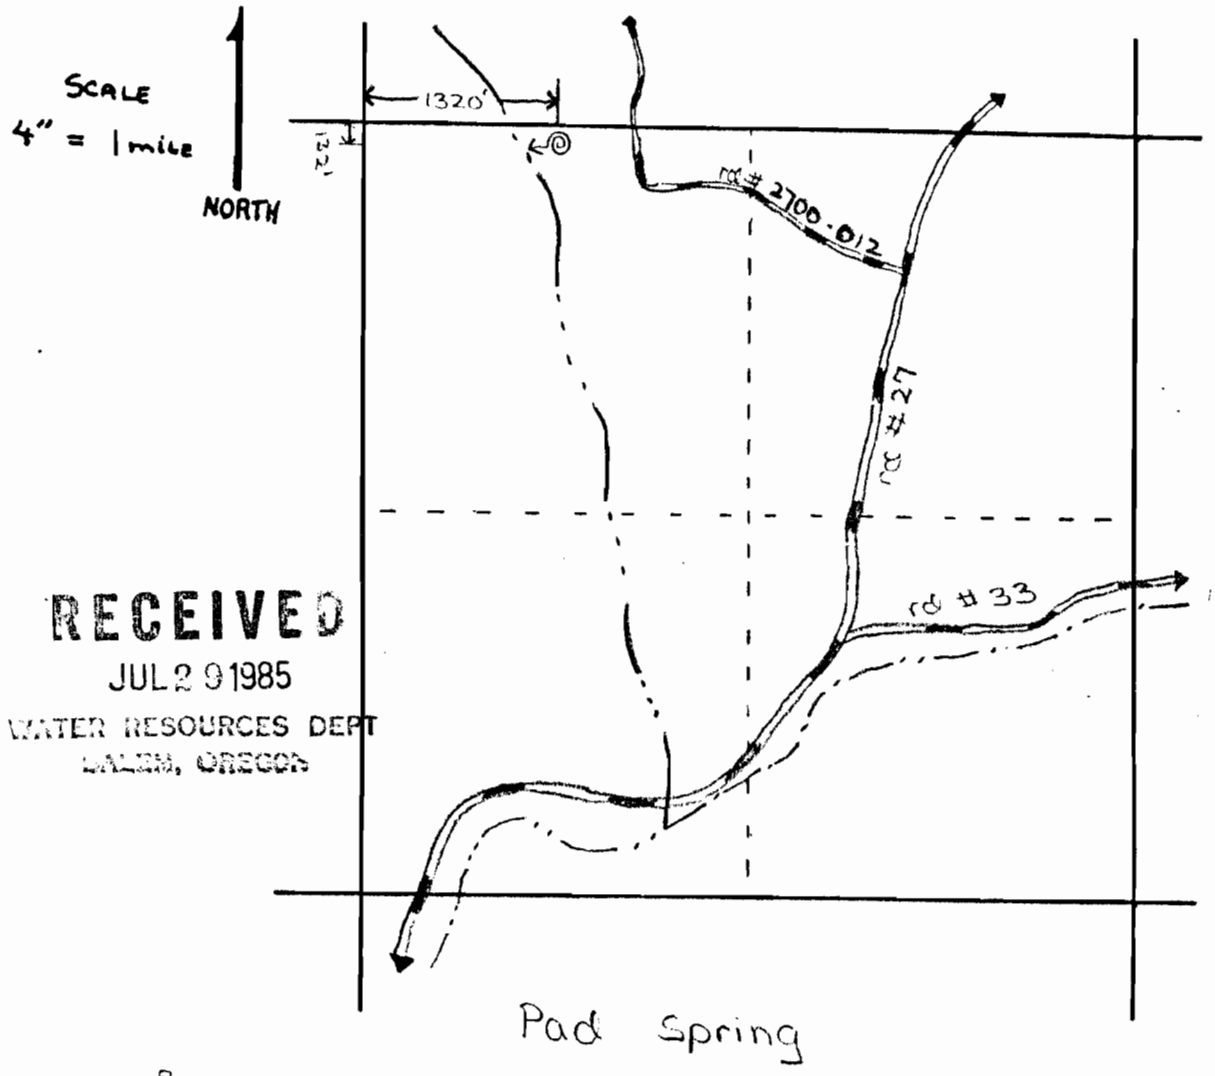

RECEIVED
JUL 29 1985
WATER RESOURCES DEPT
SALEM, OREGON



↓

Application No. 68448
Permit No. 49411

