


T13S R17E Sec 33 NW 1/4 SE 1/4

SCALE
4" = 1 mile

NORTH

RECEIVED
JUL 29 1985
WATER RESOURCES DEPT
SALEM, OREGON

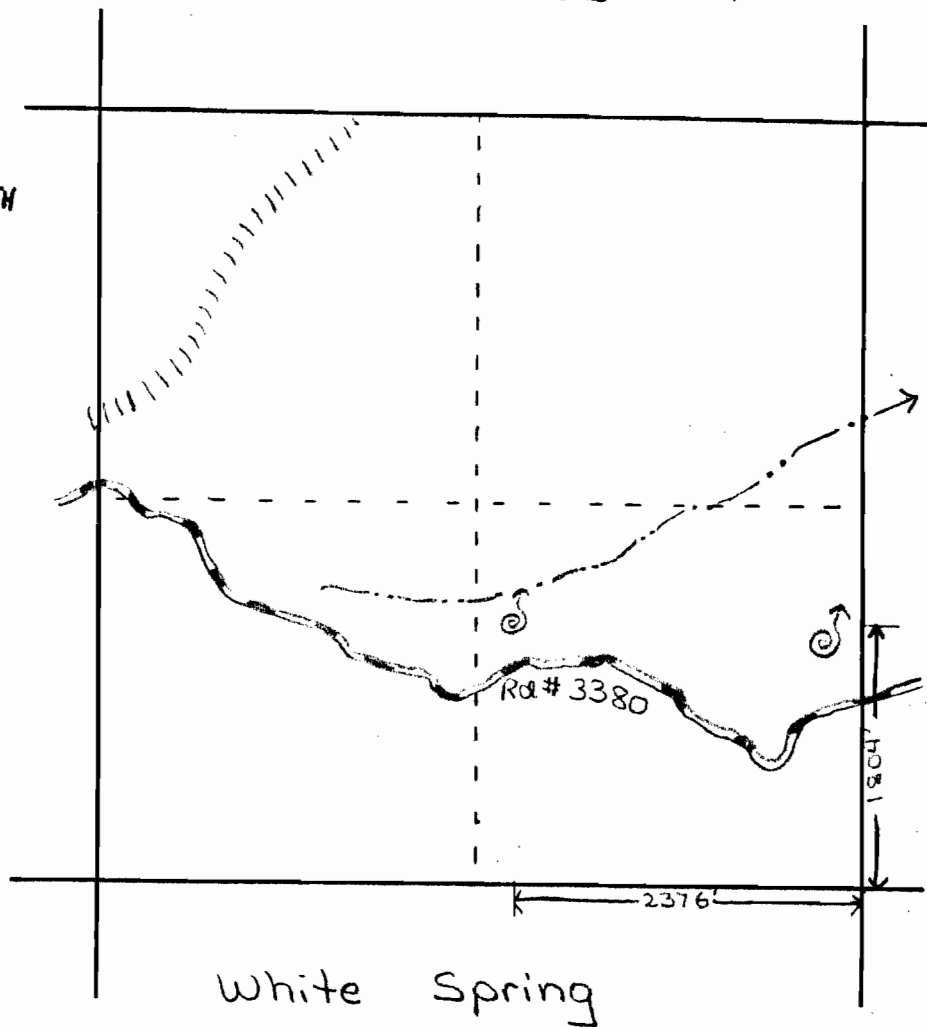

Application No. 68449
Permit No. 49442

Scale
1 inch = 40 feet

Rd # 3380
470' ↓

