

Mule Deer Spring
T17S, R19E, Sec 22, NW NE

SCALE
4" = 1 mile

NORTH


2558'

743'

Road 1700 150

RECEIVED
SEP 19 1983
WATER RESOURCES DEPT.
SALEM, OREGON

Application No. 66346
Permit No. 49531

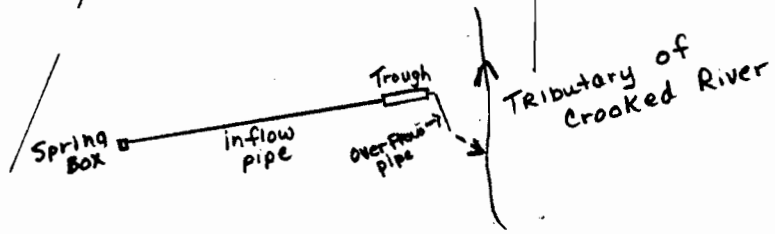

North

Scale: 1 inch = 40 feet