


SCALE
4" = 1 mile

NORTH

T13S, R17E, Sec 6, SE 1/4 SW 1/4, W.M.

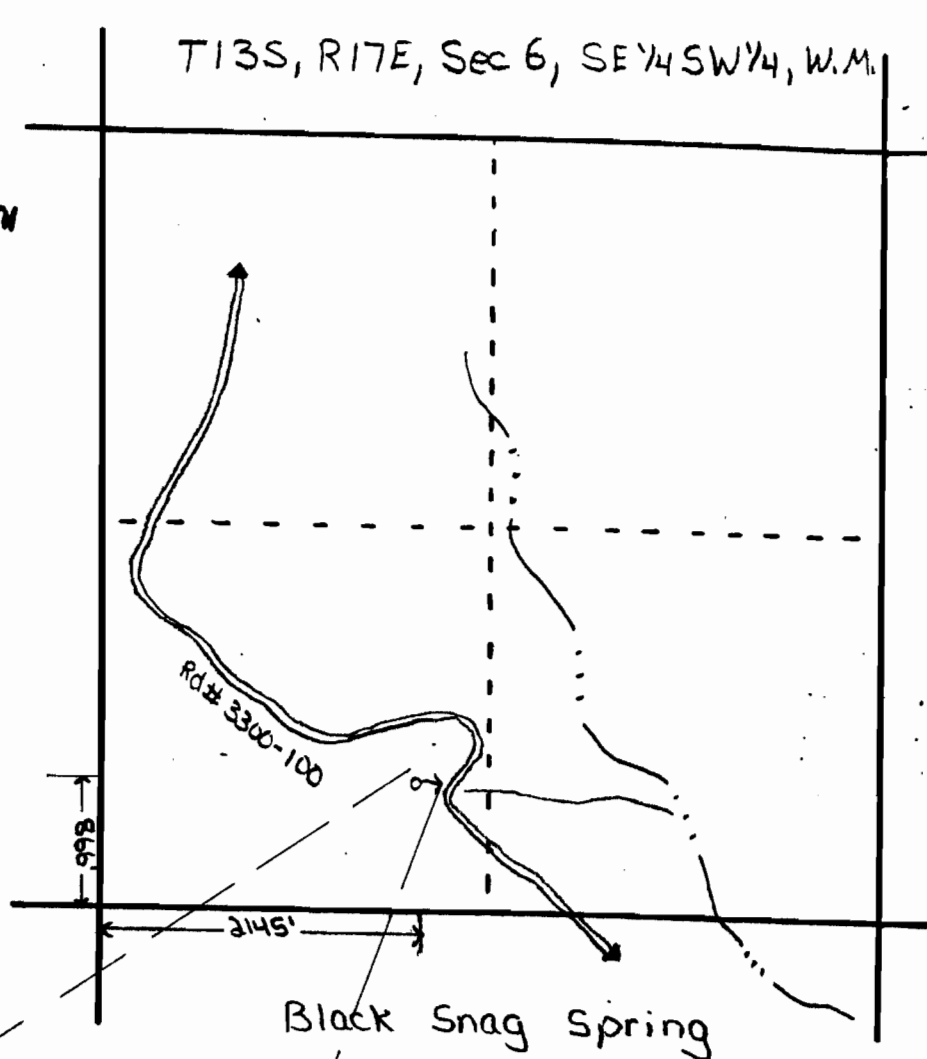

Black Snag Spring

headworks

trough
overflow

Scale 1 inch = 40 Feet

Application No. 66348
Permit No. 49533

SEP 19 1983
WATER RESOURCES DEPT.
SALEM, OREGON