


Cowse Spring


SCALE
4" = 1 mile

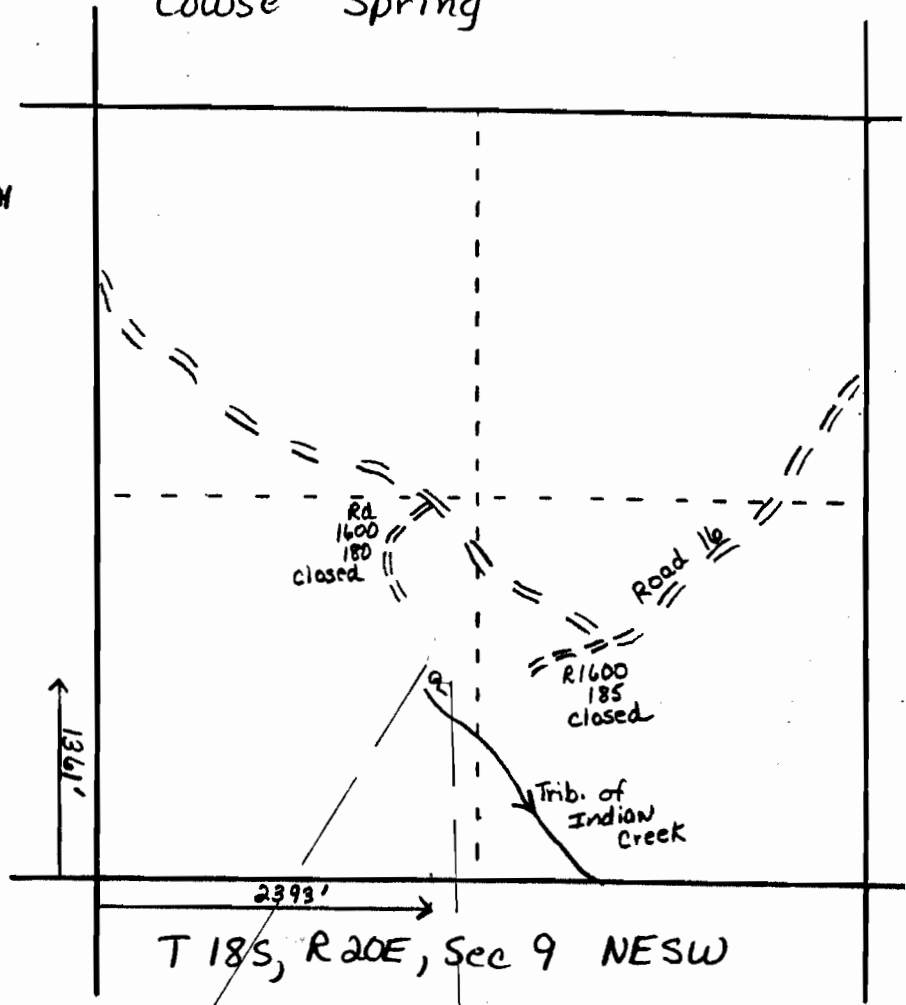

RECEIVED
SEP 19 1983
WATER RESOURCES DEPT.
SALEM, OREGON



Application No. 66351
Permit No. 49536

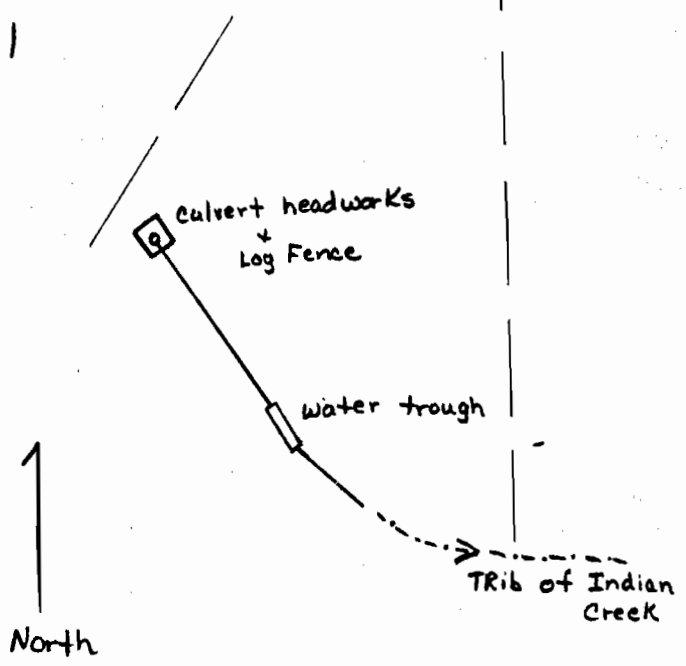

Scale: 1 inch = 40 feet