



RECEIVED
SEP 19 1983
WATER RESOURCES DEPT.
SALEM, OREGON

SCALE
4" = 1 mile
NORTH

Grouse Spring

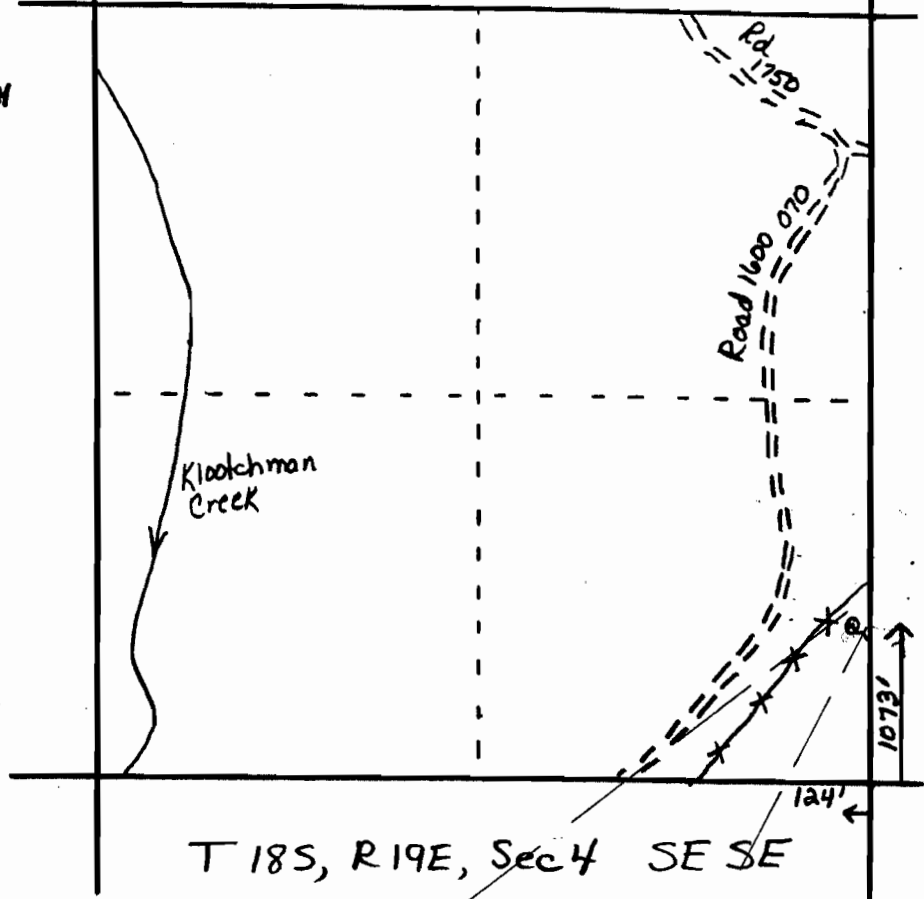

Application No. 66352
Permit No. 49537

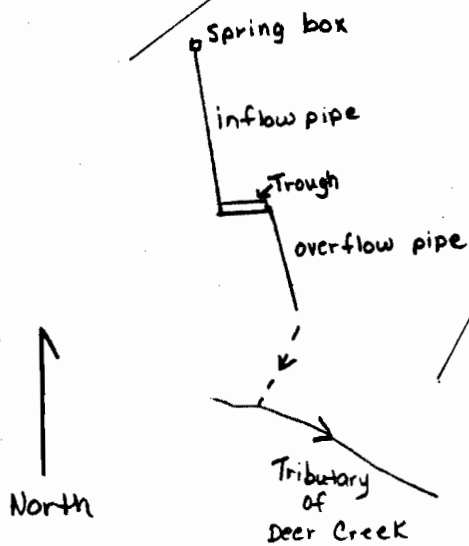

Scale: 1 inch = 40 feet