

SCALE
4" = 1 mile


NORTH

RIVER LEAD

SEP 19 1983

WATER RESOURCES DEPT.
SALEM, OREGON

Knox Spring
T 17S, R 19E, Sec 22 NE SE

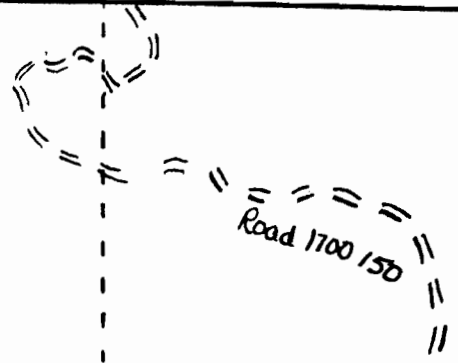

2145'

371'

Application No. 66353
Permit No. 49538

Head box

Inflow Pipe

over Flow Pipe

Trough

Tributary of
Pine Creek

North

Scale: 1 inch = 40 feet