


SCALE  
4" = 1 mile  
NORTH

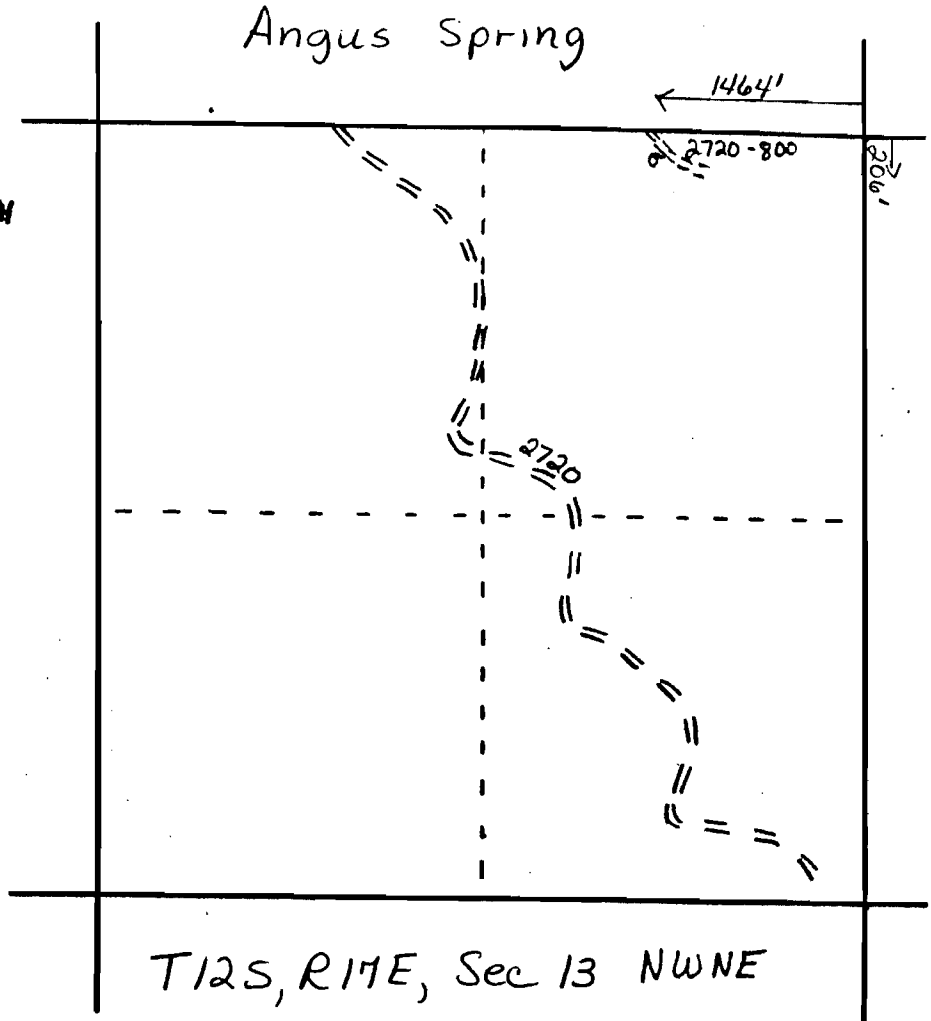

SEP 19 1983  
LAND RESOURCES DEPT.  
SALEM, OREGON

Application No. 66355  
Permit No. 49540

N  
Scale 1 inch = 40 feet

