


SCALE  
4" = 1 mile  
NORTH ↑

S... 9 1983  
DES DEPT.  
SALEM, OREGON

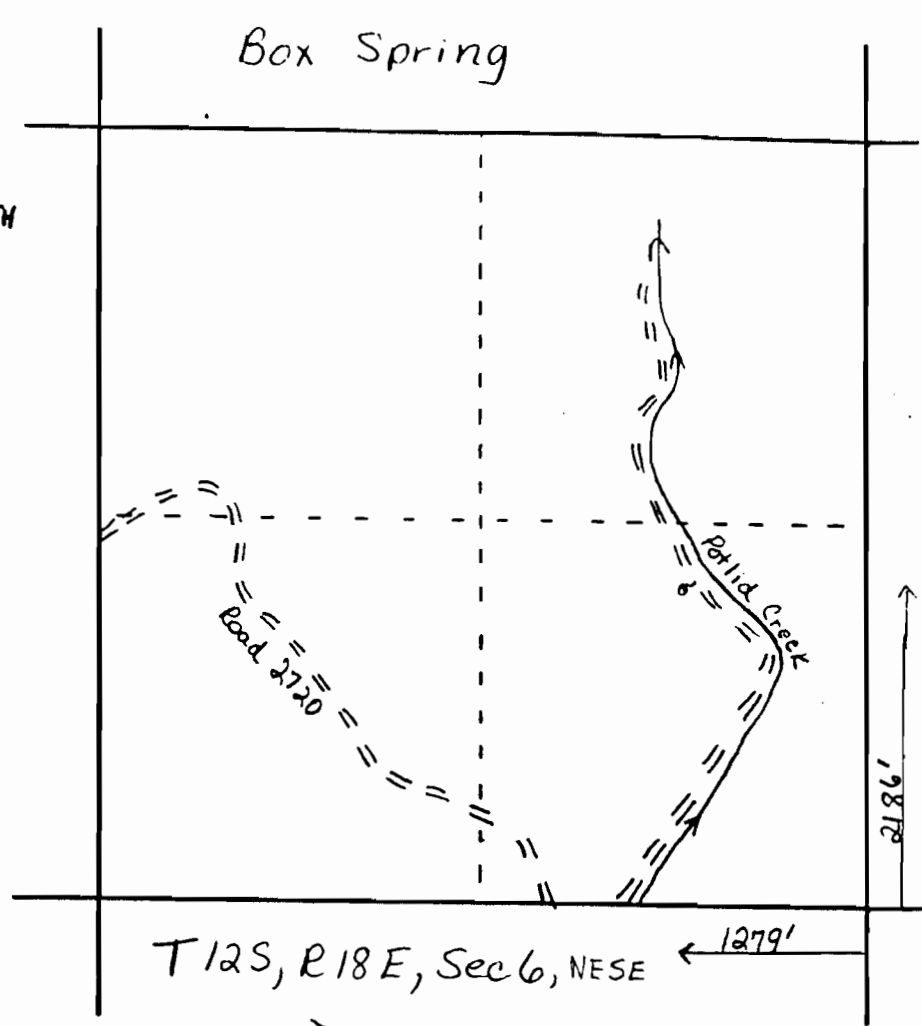

Application No. 66356  
Permit No. 49541

North ↑  
Scale: 1 inch = 40 feet

