


T17S, R20E, Sec 29, W.M.
NW 1/4 SE 1/4

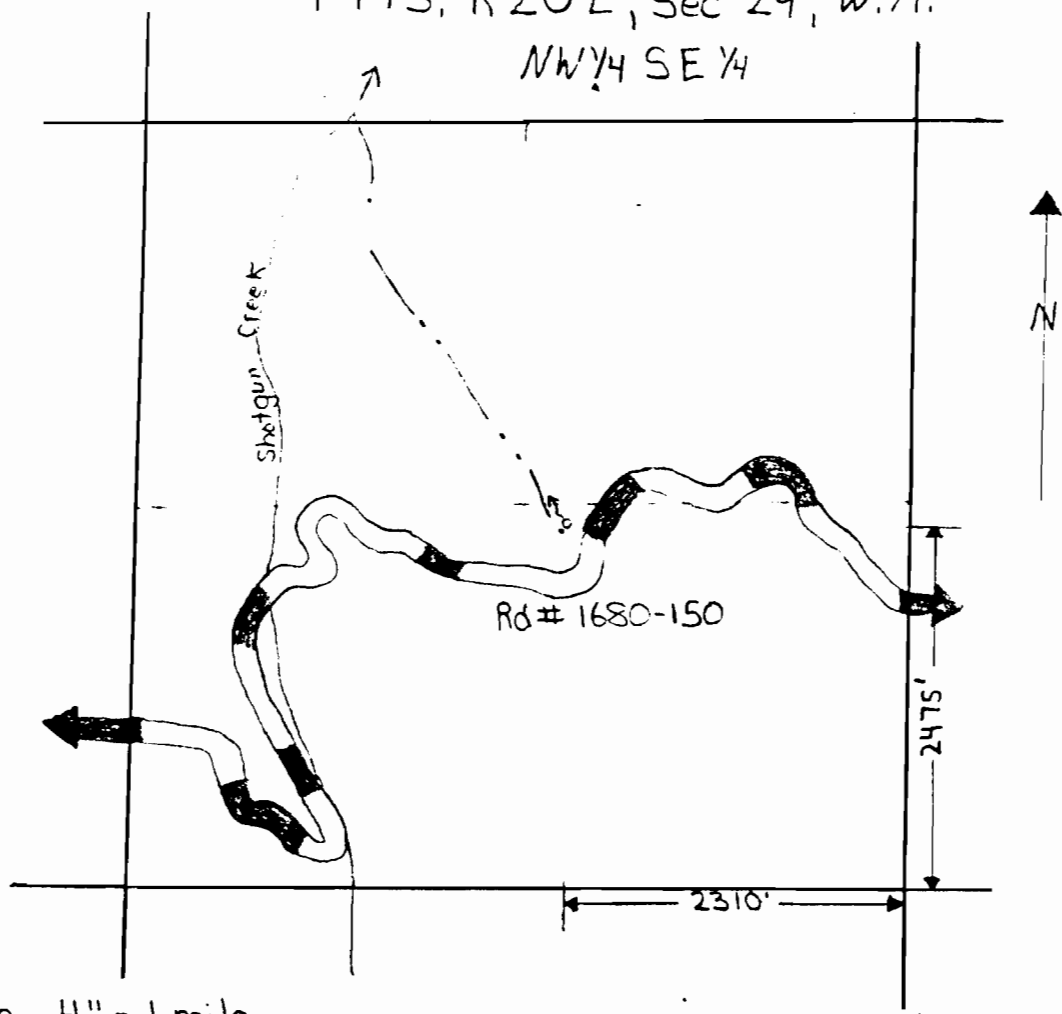


Scale 4" = 1 mile

Wilfol Spring

SEP 29 1983

Scale 1" = 40'

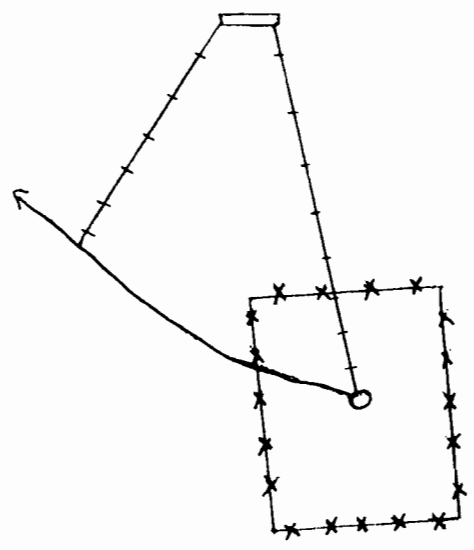

Application No. 66357
Permit No. 49512

Rd #
1680-150
2111