


SCALE
4" = 1 mile

NORTH

King Spring


SEP 9 1983

WATER RESOURCES DEPT.
SALEM, OREGON

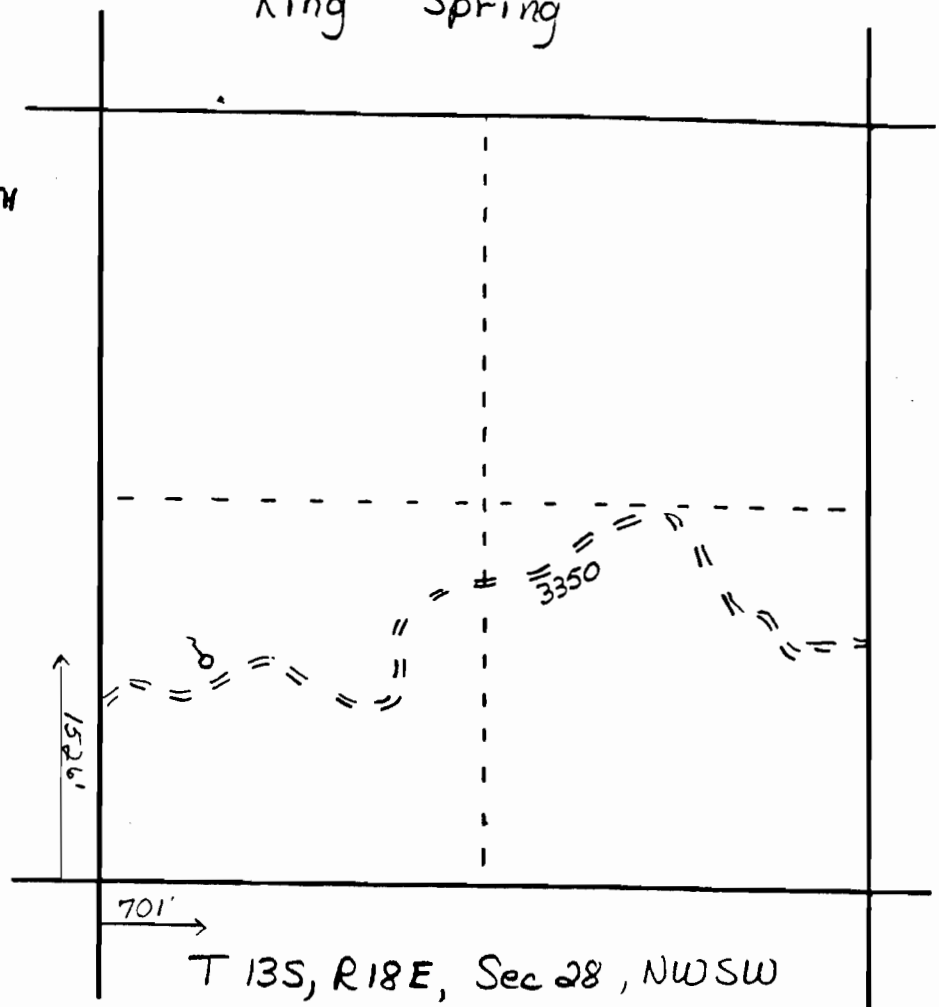

Application No. 66358
Permit No. 49543

Tributary
of
Benefield
Creek

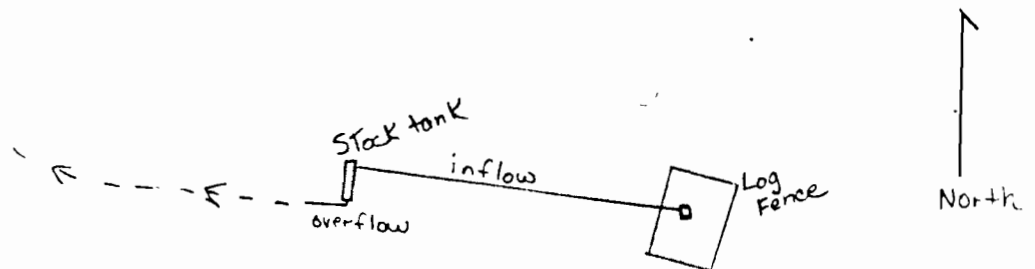

Scale: 1 inch = 40 feet