



Sherwood Spring T18S, R19E, Sec6 SE SW

SCALE
4" = 1 mile
NORTH

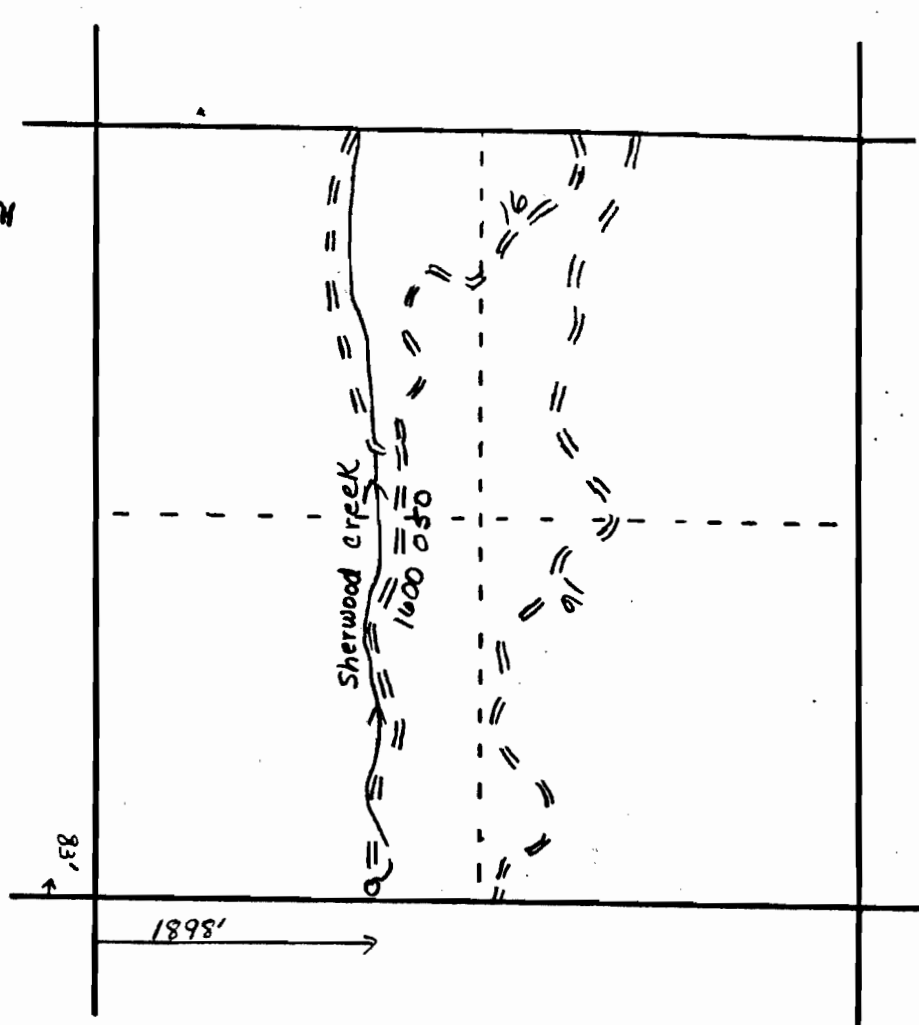

Application No. 66359
Permit No. 49544

North
Scale 1 inch = 40 feet

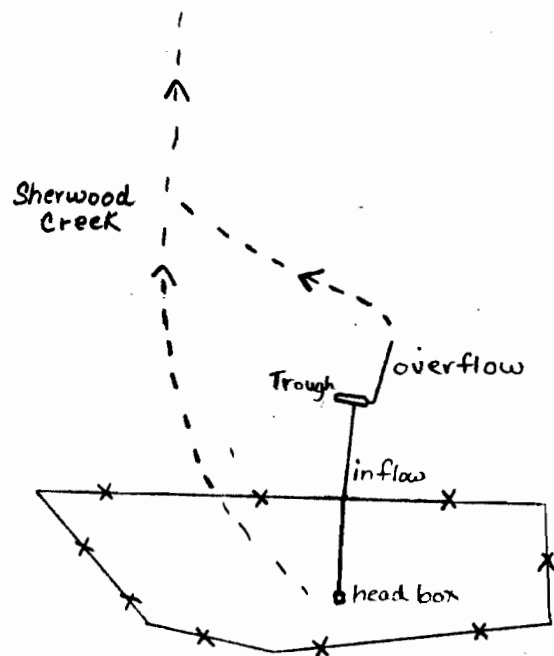

SEP 19 1983
WATER RESOURCES DEPT.
SALEM, OREGON