

Scale
4" = 1 mile

NORTH

Coyote Spring

2104

1279


closed
road

T17S, R20E, Sec 26 NE NW

Application No. 66363
Permit No. 43548

North

Scale: 1 inch = 40 feet

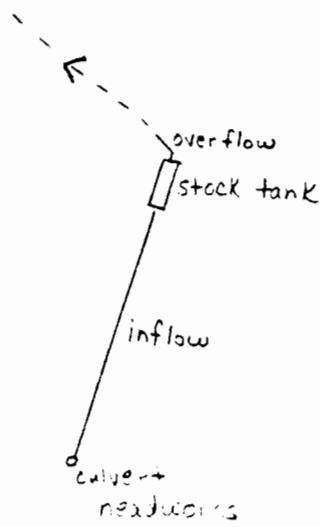

SEP 9 1983
WATER RESOURCES DEPT.
SALEM, OREGON