




SCALE
4" = 1 mile

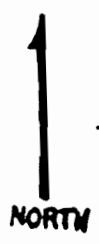

Miller Spring

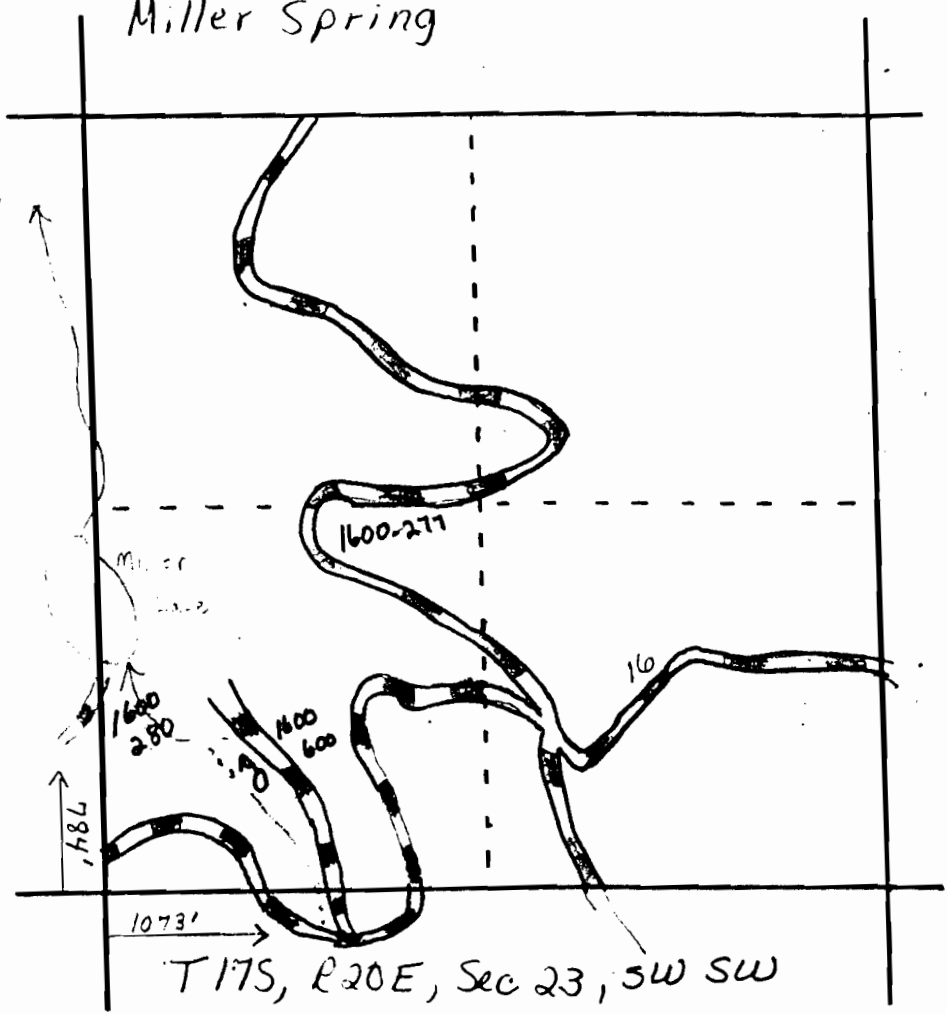

Application No. 66364
Permit No. 49519

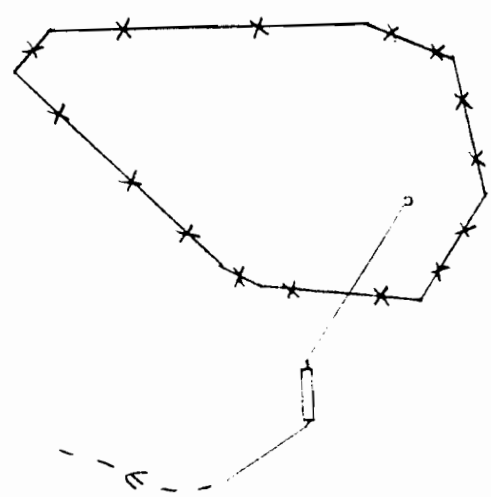

Scale: 1 inch = 40 feet

SEP 29 1983
WATER RESOURCES DEPT.
SALEM, OREGON