



SCALE
4" = 1 mile

NORTH

Meyer Spring

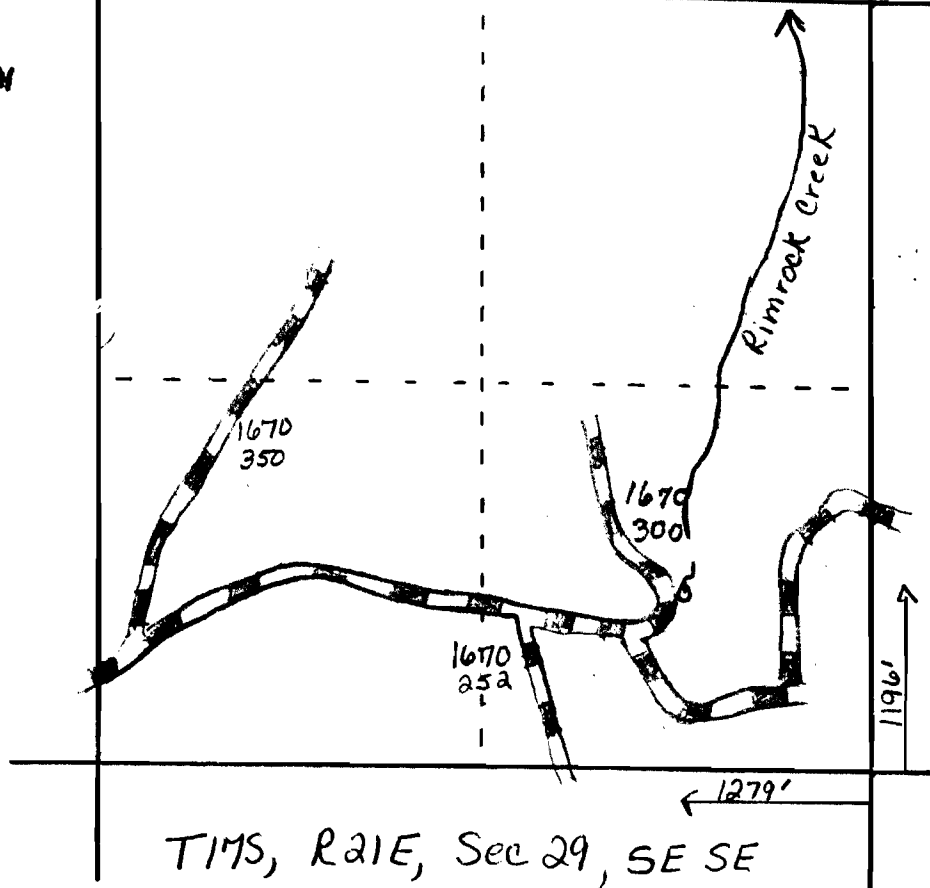

Application No. 66365
Permit No. 49550

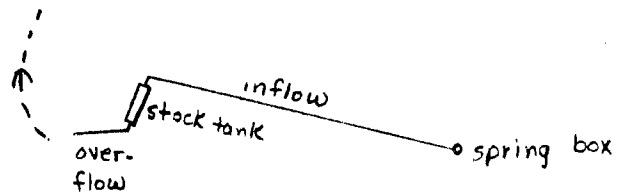

North

Scale: 1 inch = 40 feet

RECEIVED
SEP 19 1983
SALEM, OREGON