



Summit Spring

T17S., R20E, Sec 36, SESE

SCALE
4" = 1 mile
NORTH

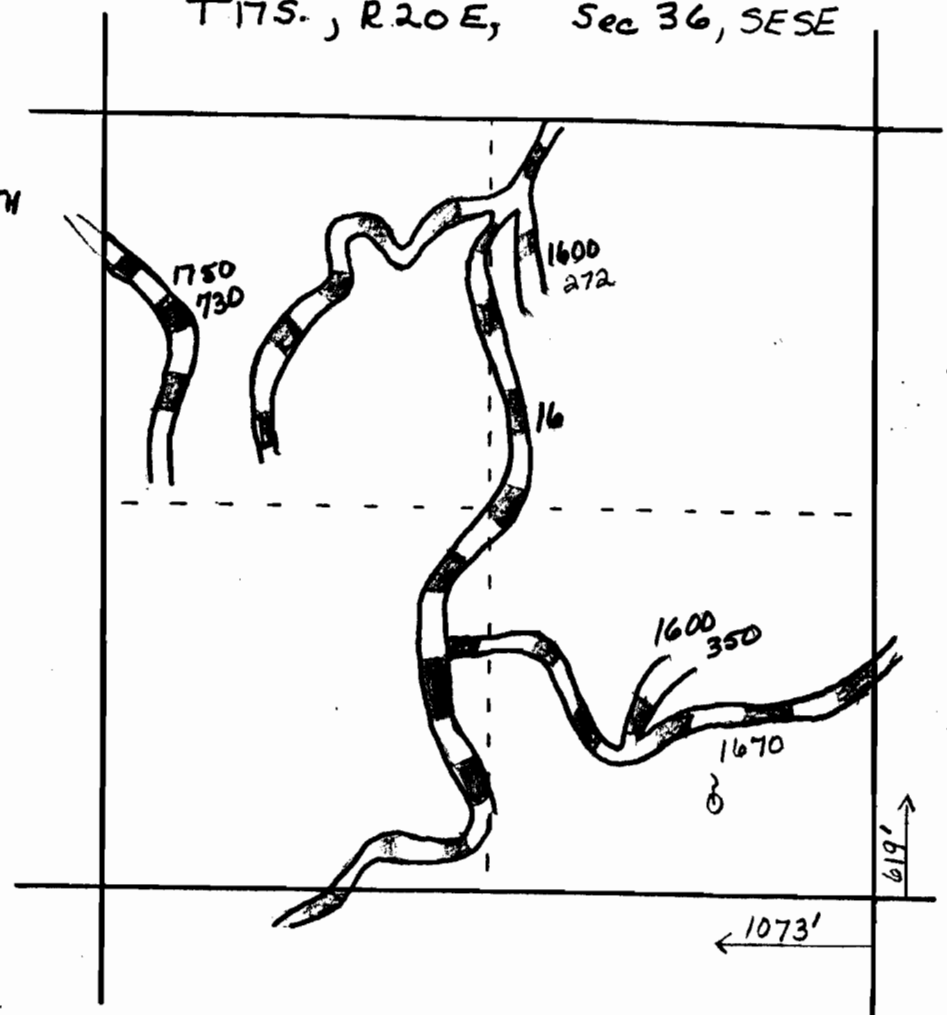

Application No. 66366
Permit No. 49551

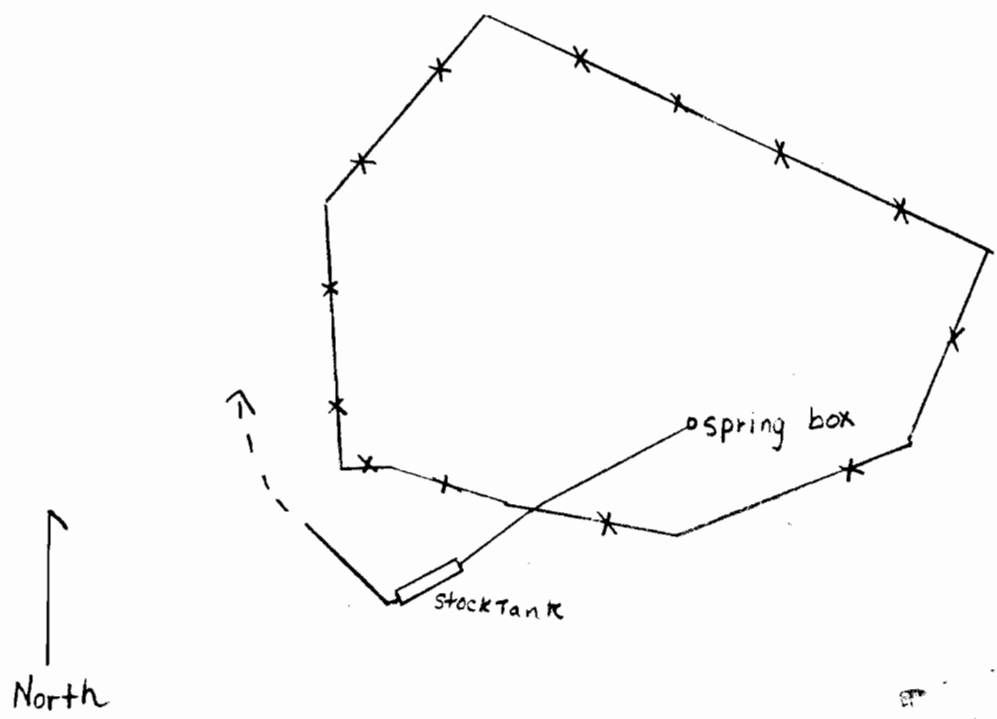

Scale 1 inch = 40 feet

SEP 19 1983
SOS DEPT.
SALEM, OREGON