


7100  
63995

23

24

4540

Unnamed Spring  
SW NE Sec. 26

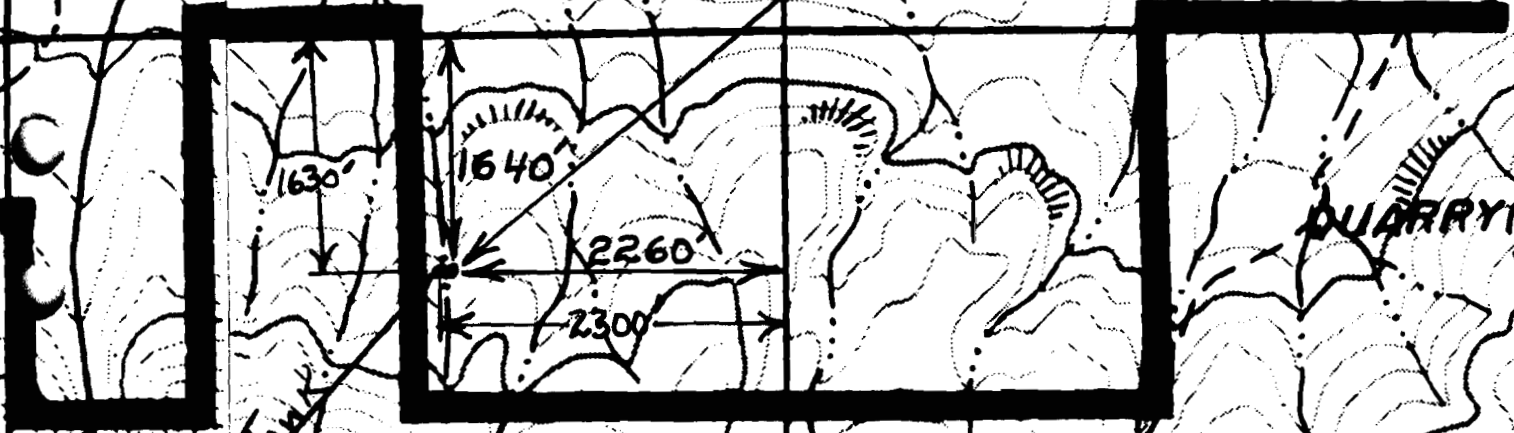

QUARRY

T36S, R10E

Scale 4" = 1 Mile

5000

5000

Winema National Forest

Application No. 68428

Permit No. 49639

35

36

R. 10E.