


N

RECEIVED

APR 29 1987

LAND DIVISIONS DEPT
SALEM, OREGON

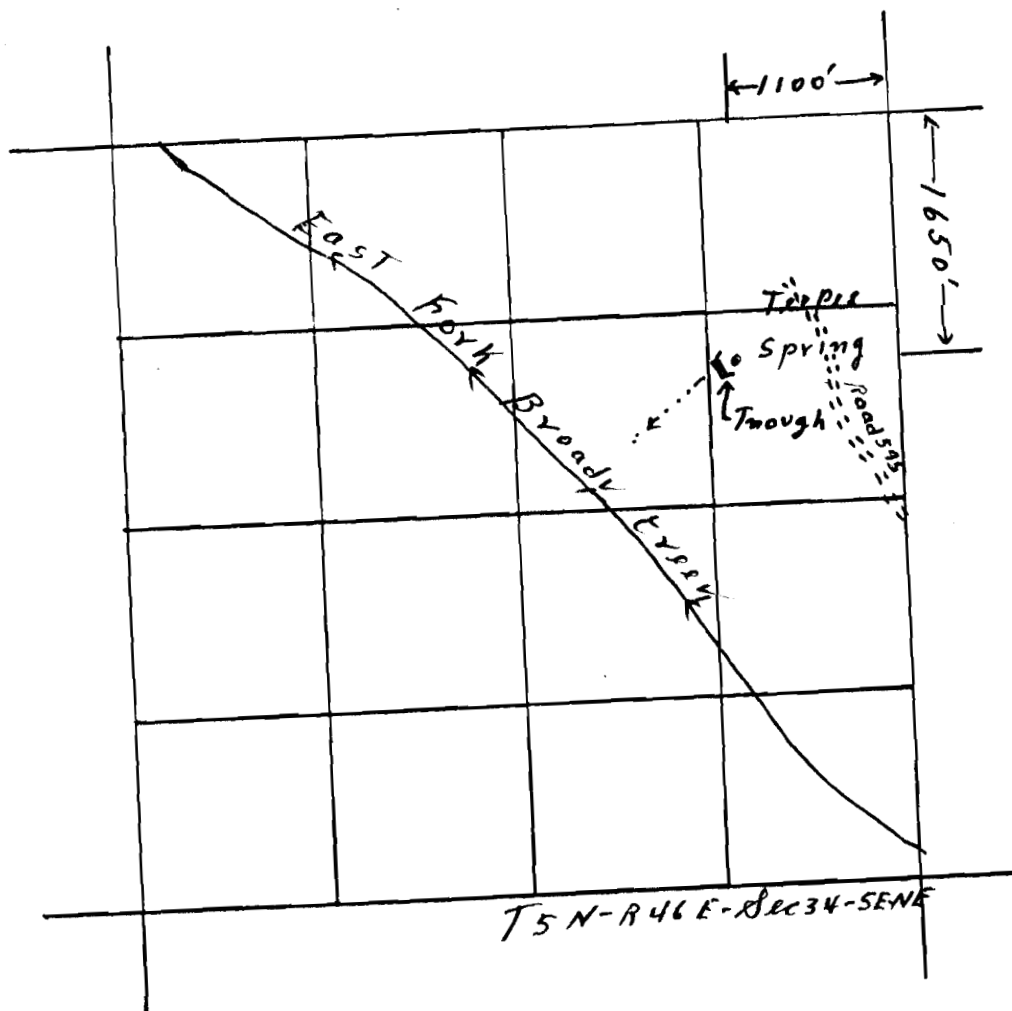

4 inches = 1 mile

Application No. 65746
Permit No. 49732