


N ↑

RECEIVED

APR 29 1982

U.S. GEOLOGICAL SURVEY  
SALEM, OREGON

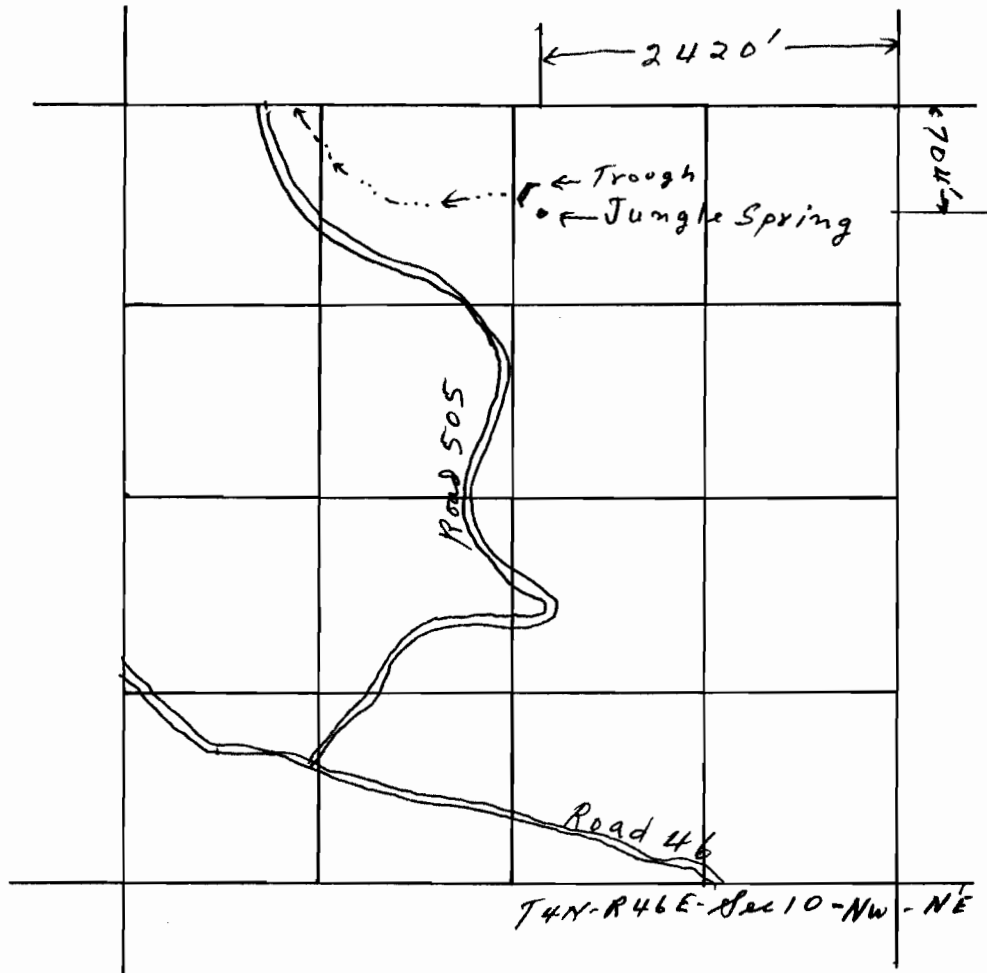

4 inches = 1 mile

Application No. 65751  
Permit No. 49737