


N ↑

RECEIVED  
MAY 29 1932  
LAND REVENUE DEPT  
SALEM, OREGON

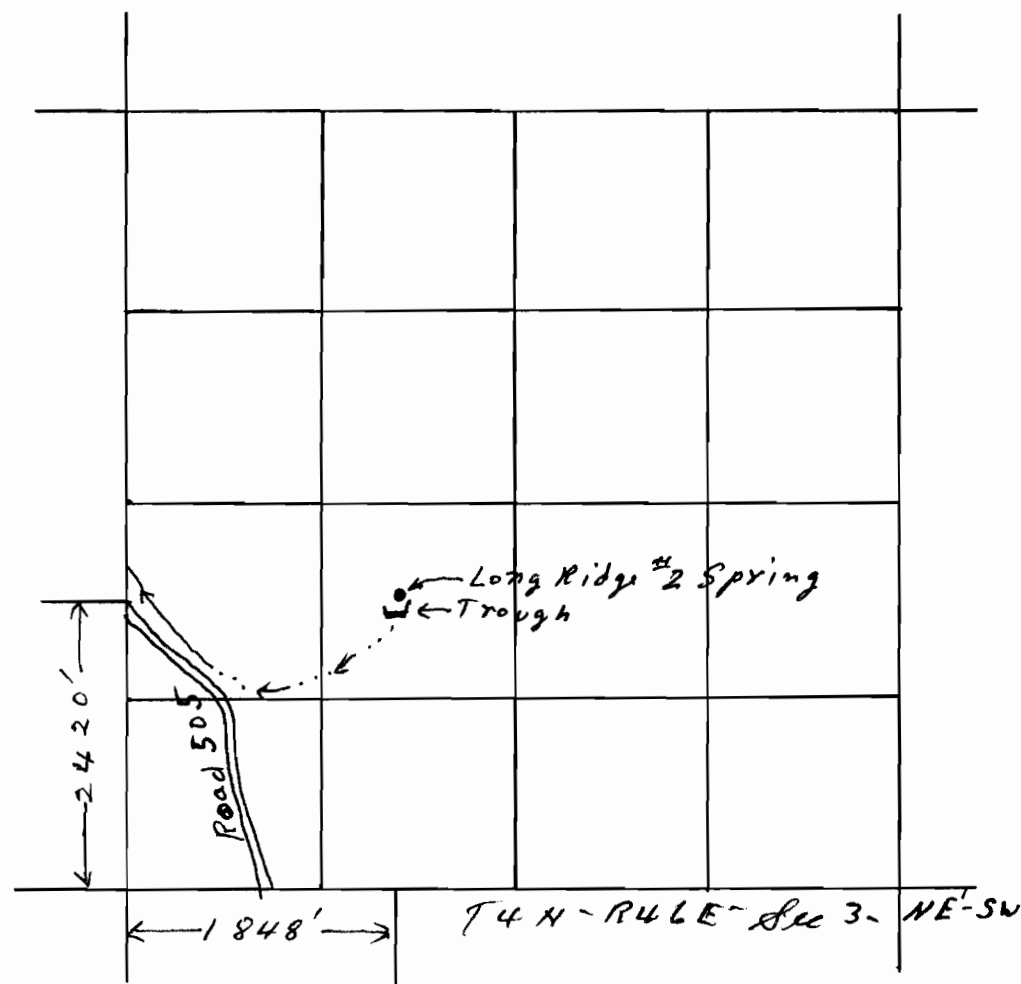

4 inches = 1 mile

Application No. 65752

Permit No. 49738