


RECEIVED
APR 29 1932
COUNTY REC. DEPT
SALEM, OREGON

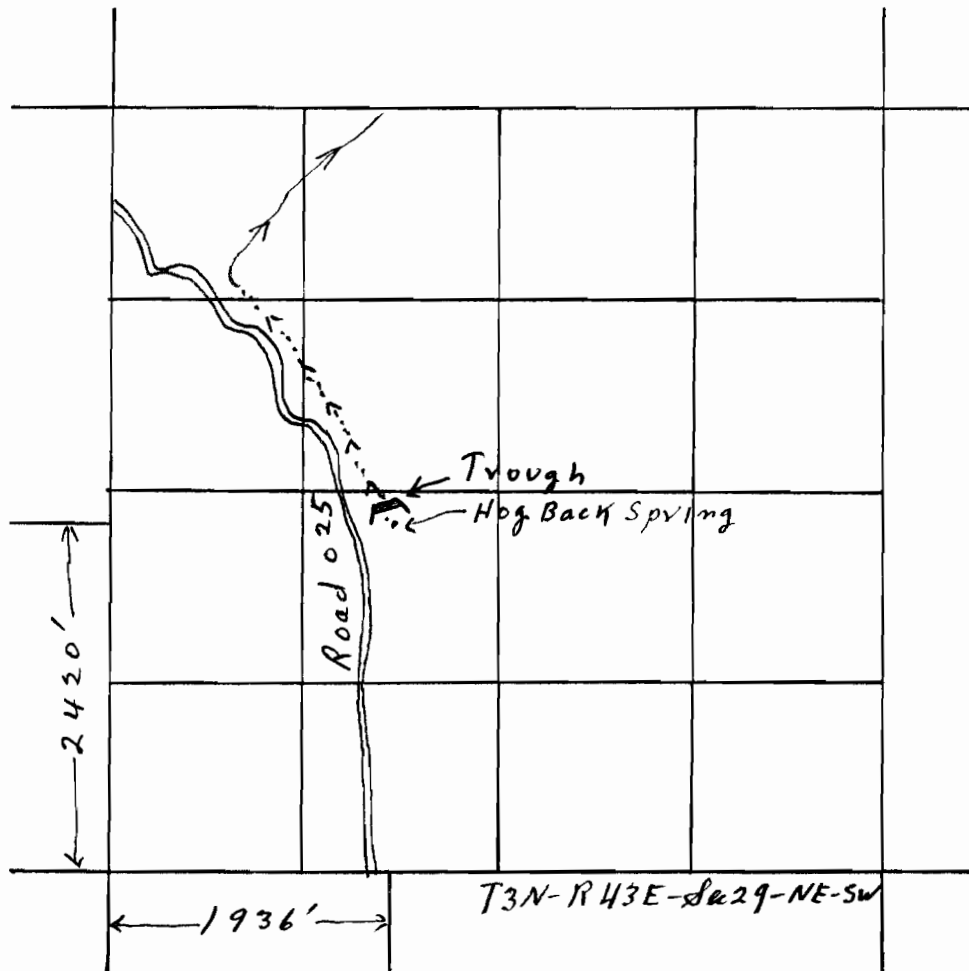

4 inches = 1 mile

Application No. 65754
Permit No. 49740