


RECEIVED
APR 19 1987
LAND REVENUE DEPT.
SALEM, OREGON

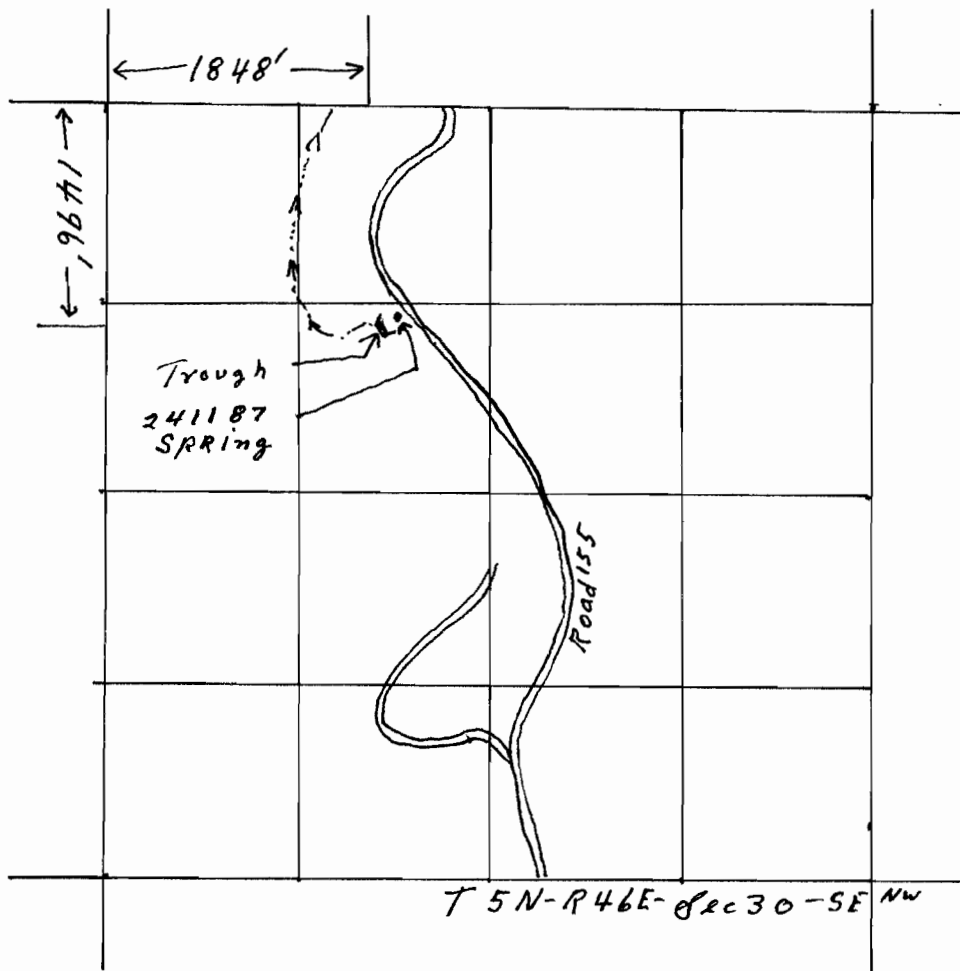

4 inches = 1 mile

Application No. 65755

Permit No. 49741