


N ↑

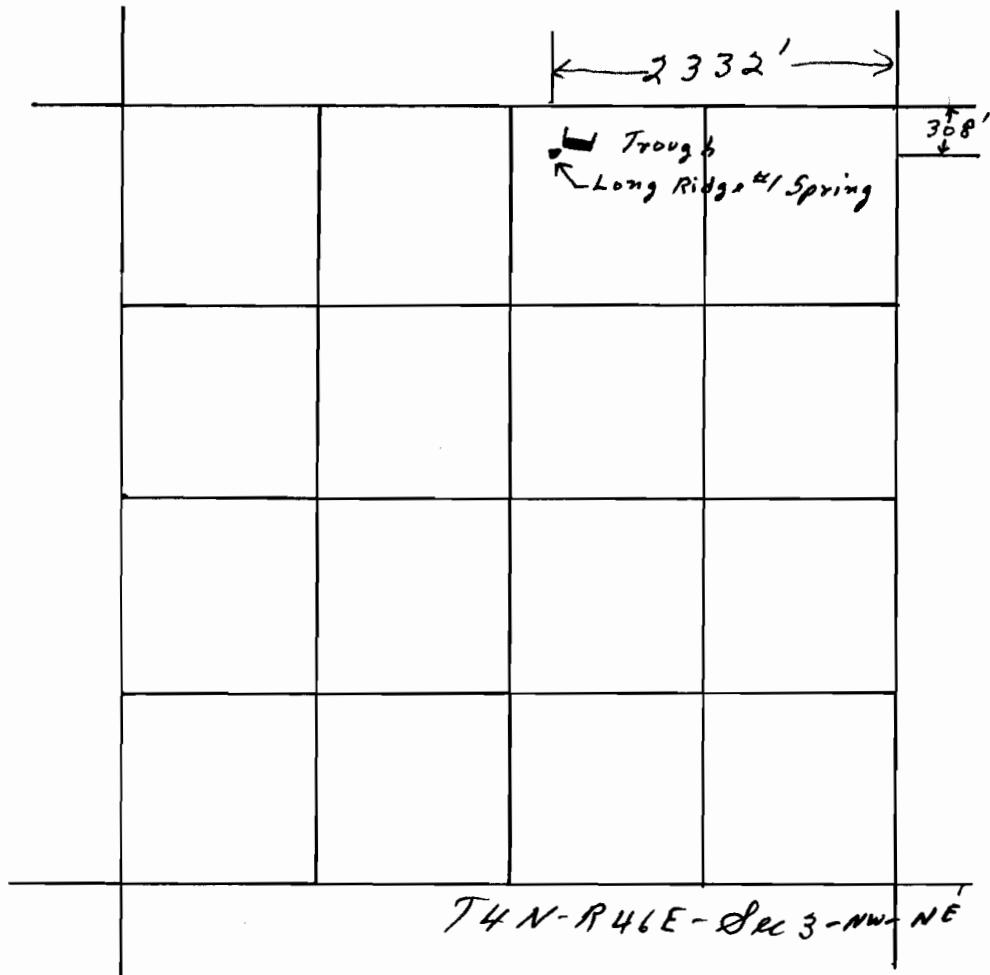

1/4 inches = 1 mile

Application No. ~~6757~~ 65757
 Permit No. 49743

SALEM, OREGON
 LAND RESOURCES DEPT.
 APR 29 1988
 RECEIVED