


T10S R39E WM

Section 4

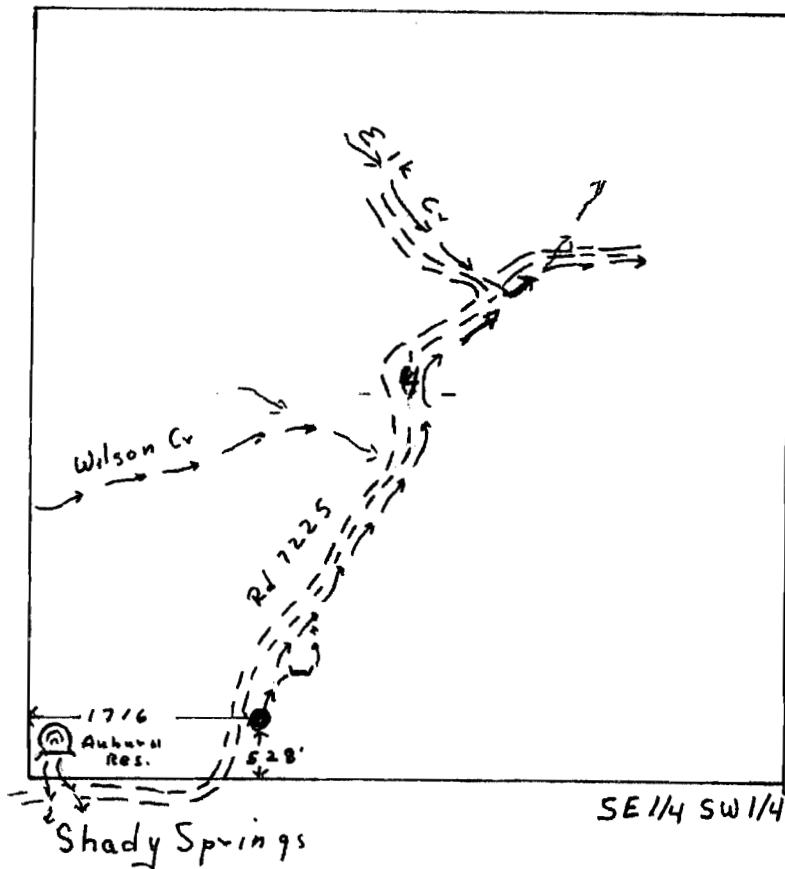

**RECEIVED**

SEP 22 1983  
WATER RESOURCES DEPT.  
SALEM, OREGON

Application No. 66621  
Permit No. 49782