

RECEIVED

JAN - 4 1988

WATER RESOURCES DEPT.
SALEM, OREGON


RECEIVED

SEP 22 1983

WATER RESOURCES DEPT.
SALEM, OREGON

T 11 S R 39 E WM

Section 27

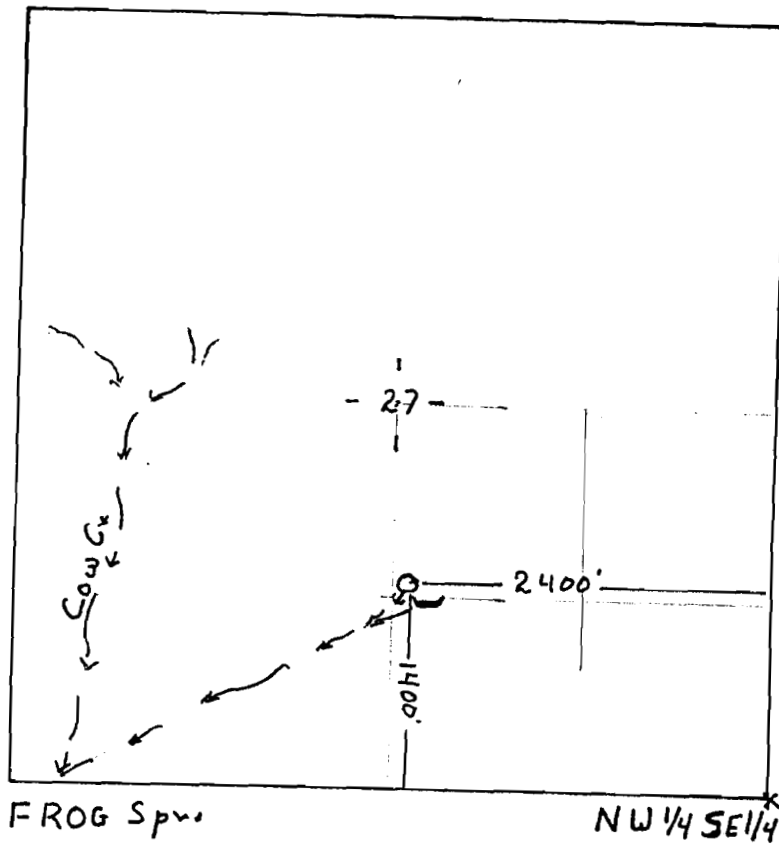

Application No. 66637
Permit No. 49798