

RECEIVED

JAN -4 1988


WATER RESOURCES DEPT.
SALEM, OREGON

SEP 22 1983

WATER RESOURCES DEPT.
SALEM, OREGON

T 12 S R 39 E WM

Section 1

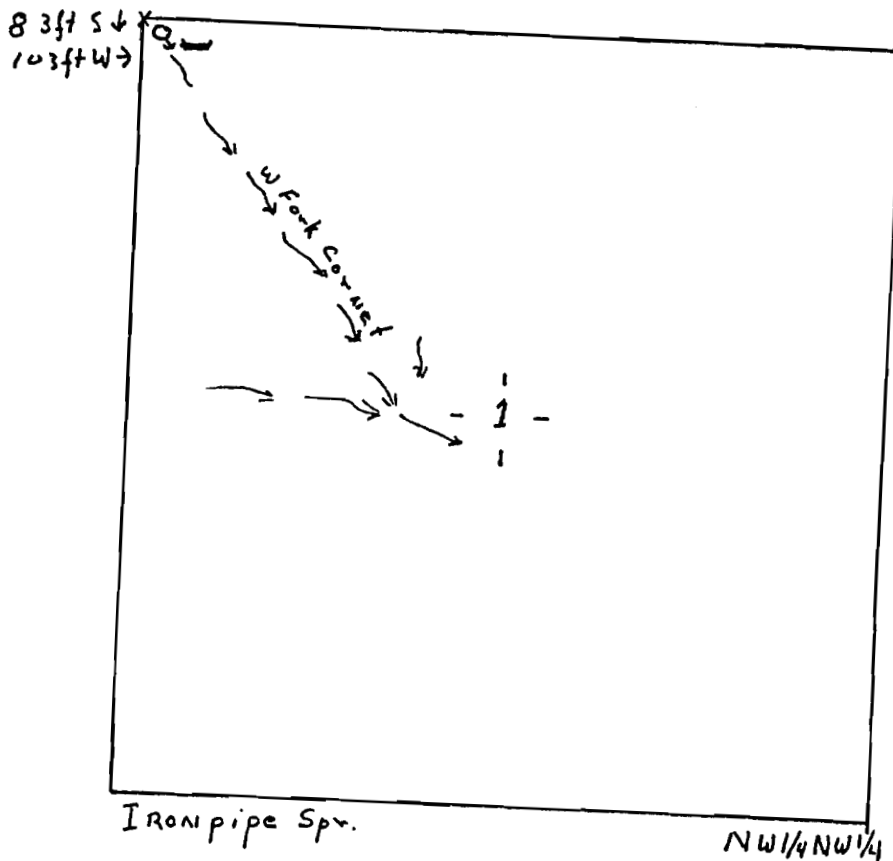

Application No. 66638
Permit No. 49799