

RECEIVED

SEP 2 1983

WATER RESOURCES DEPT.
SALEM, OREGON


RECEIVED

JAN -1 1988


WATER RESOURCES DEPT.
SALEM, OREGON

T 12 S R 39 E WM

Section 1

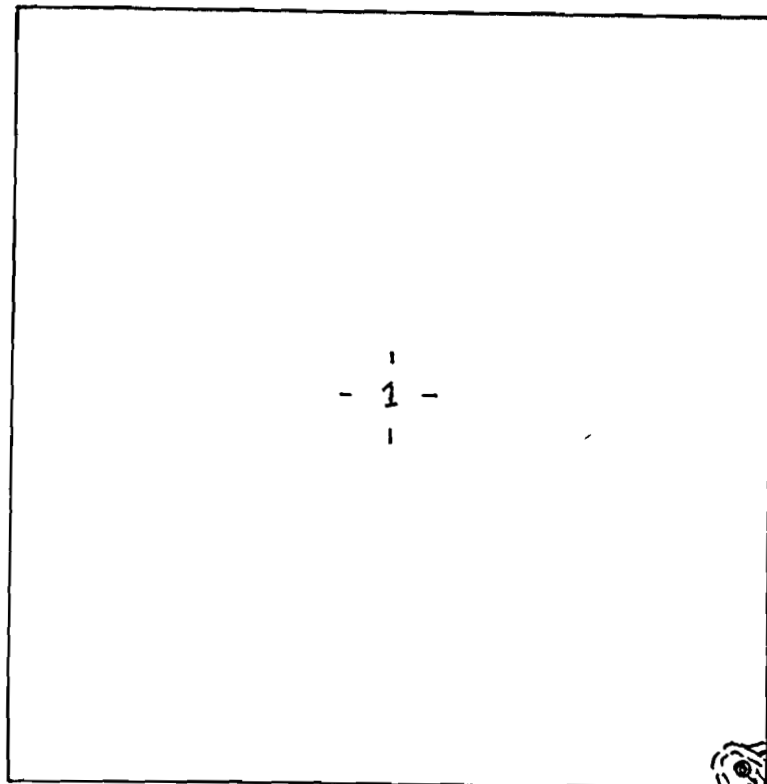

Aspen Rest

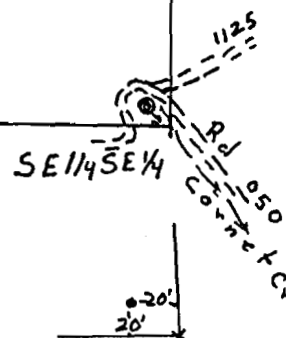

Application No. 66639
Permit No. 49800