

RECEIVED

JAN - 4 1988

WATER RESOURCES DEPT.
SALEM, OREGON


RECEIVED

SEP 2 1983

WATER RESOURCES DEPT.
SALEM, OREGON

T 11 S R 39 E WM

Section 18

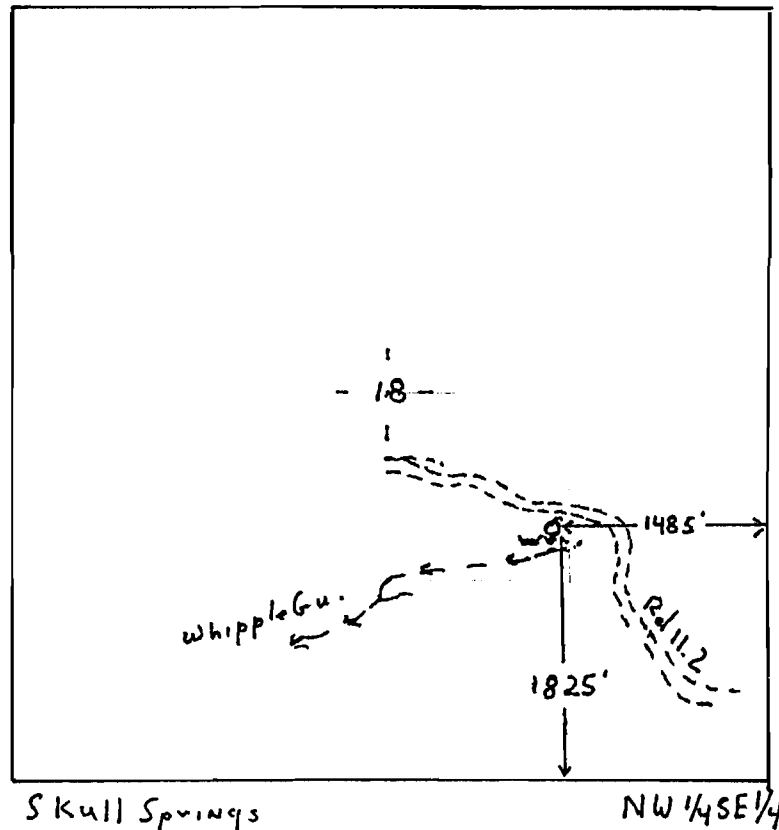

Application No. 66640
Permit No. 49801