


584

T. 23 S., R. 10 E., W. 1 M.

SECTION 27

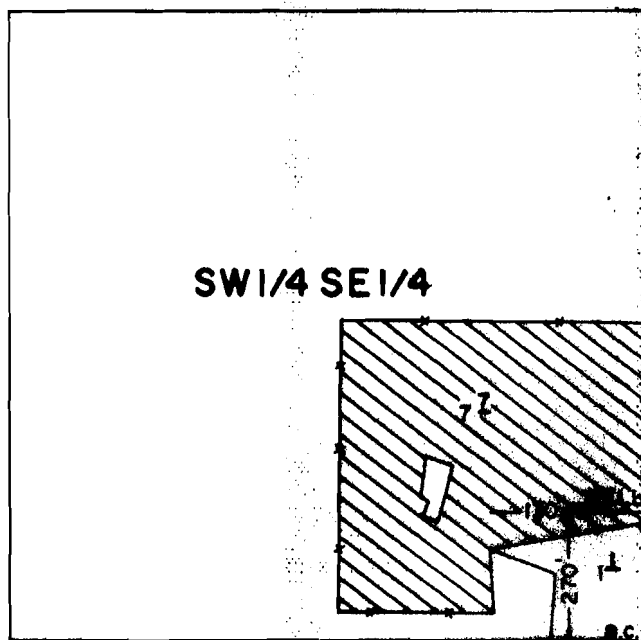

SCALE: 1" = 400'

FINAL PROOF SURVEY
UNDER

Cert. #64008

Application No. G-9447. Permit No. G-8853...
IN NAME OF

ROBERT J. & WILLIAM E. EVERLY

Surveyed JUNE 28, 1989, by B. W. BISHOP.....

9-20-89
PTS

gk
G8653