


# T. 8 S., R. 39 E., W. M.

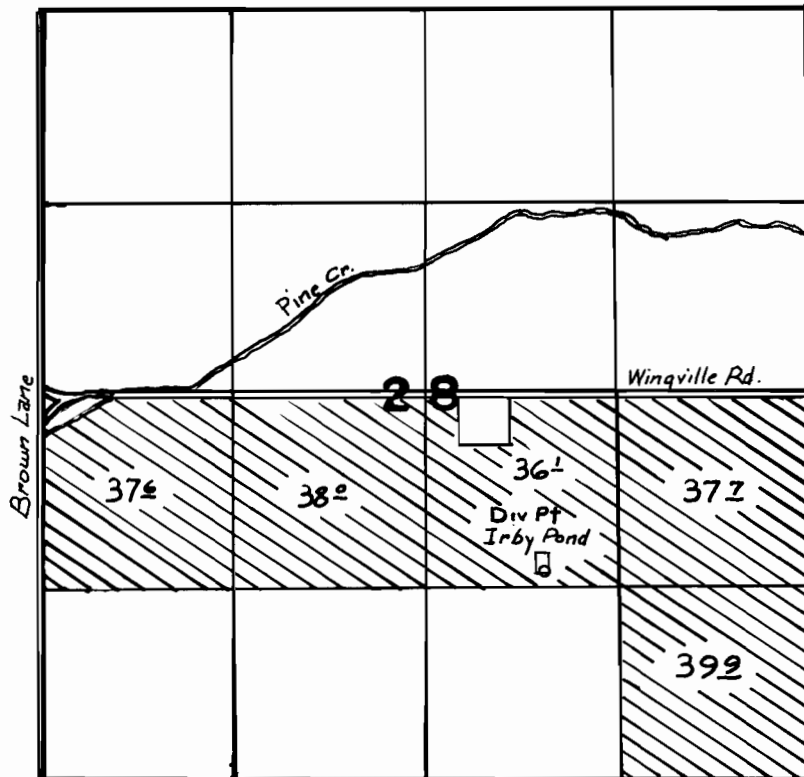

Scale 1" = 1320'

DIV PT 1500' N. & 1850' W. FROM SE COR. SEC 28

## FINAL PROOF SURVEY UNDER

Application No. **G9801** Permit No. **G9056**  
IN NAME OF

**DAVID L. & JENNIFER J. BLATCHFORD**

Surveyed **Apr. 13, 1987**, by **V.L. Church**...