
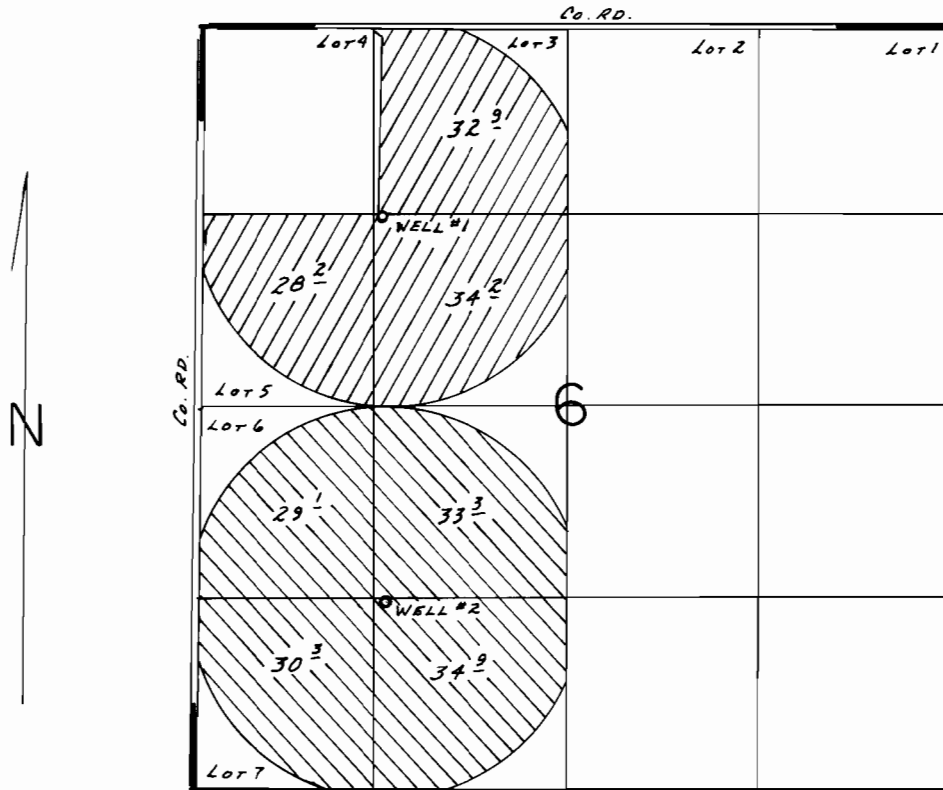


T.27S., R.18E., W.M.

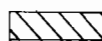

WELLS LOC.: #1-1300'S. & 1250'E. FROM NW COR. SEC. 6.
 #2-1300'N. & 1300'E. FROM SW COR. SEC. 6.

 Well #1

 Well #2

SCALE: 1" = 1320'

FINAL PROOF SURVEY UNDER

Application No. G-9835. Permit No. G-9347.....
 IN NAME OF

.....TERRY L. NOFZIGER.....

Surveyed ..Aug. 30. 1988., by B.W. BISHOP.....
 Oct. 23 1981 L.M. TOLL