
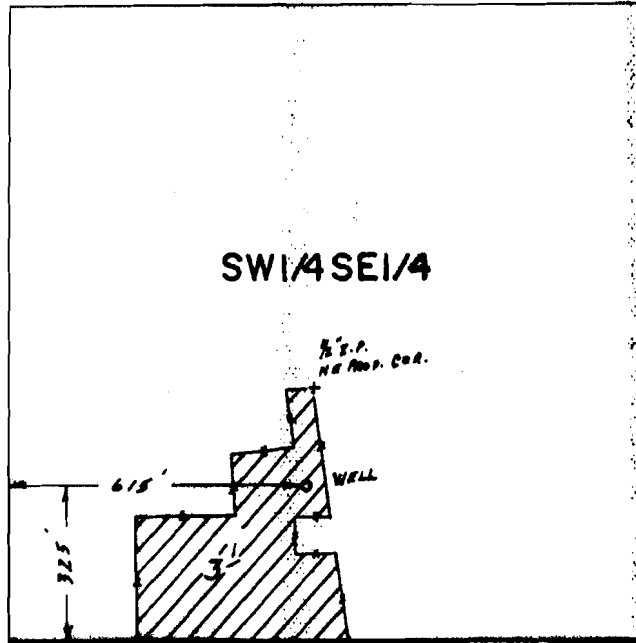


T.14S., R.11E., W.M.

SEC. 33

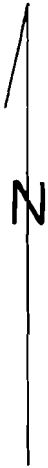

SCALE: 1" = 400'

FINAL PROOF SURVEY
UNDER

Application No. G-9839. Permit No. G-9448
IN NAME OF

JAMES R. NEAL

Surveyed Sept. 27, 1988, by B.W. RISHOP

Cont. 64012

RECEIVED

DATE 2-28-90

WATER MASTER DISTRICT #11

BY *SMW*

G-9448

11-18-88

PT 11-18-88