


T. 8 S., R. 2 W., W.M.

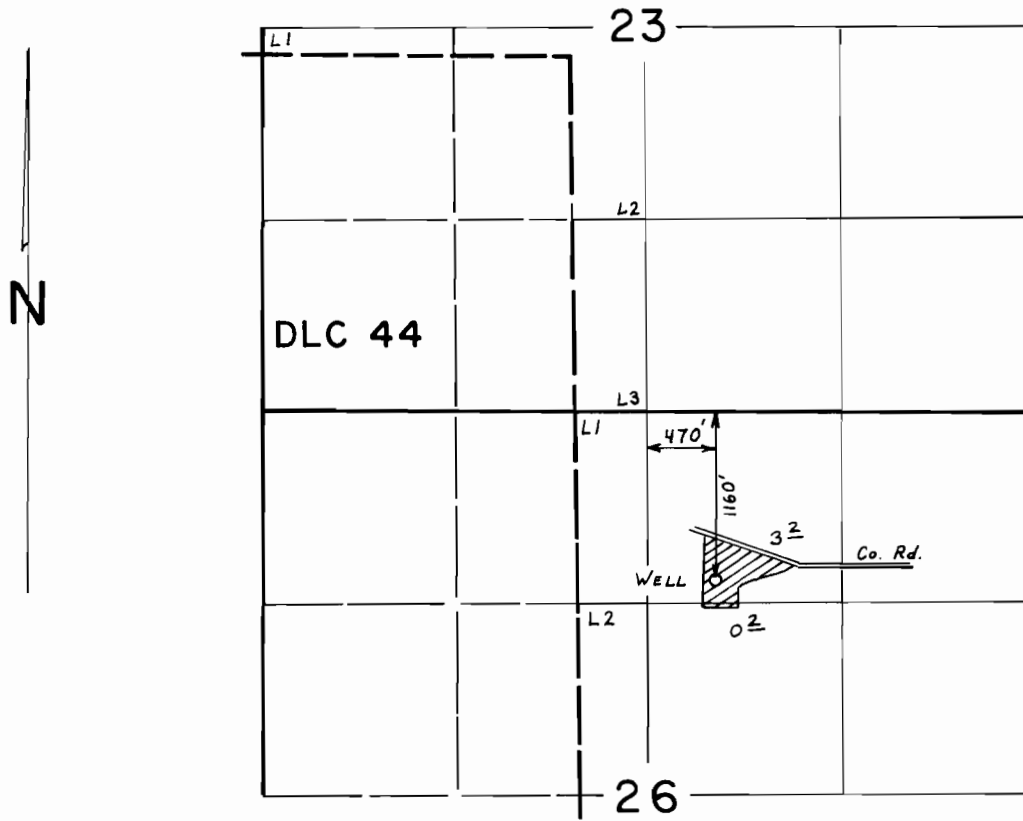

SCALE : 4" = 1 mile

FINAL PROOF SURVEY
UNDER

Application No. G-10014. Permit No. G-9149.....
IN NAME OF

ROBERT R. BURNS

Surveyed NOV. 16, 1984, by .B. BISHOP.....