


T.14S., R.10E., W.M.

SEC. 33

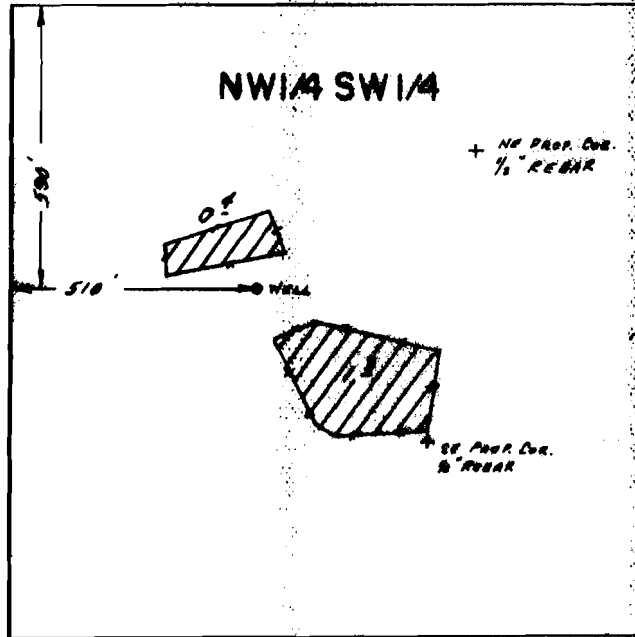

SCALE: 1"=400'

**FINAL PROOF SURVEY**  
UNDER

Application No. G-10054 Permit No. G-9161.....  
IN NAME OF

**ROBERT H. LOUD FAMILY TRUST**

Surveyed July 26... 1988, by B.W. BISHOP

*Cert. 64014*

RECEIVED

DATE 2-28-90

WATER MASTER DISTRICT #11

BY mg

G-9161  
4/8/88  
BWB