




T. 27 S., R. 18 E., W.M.

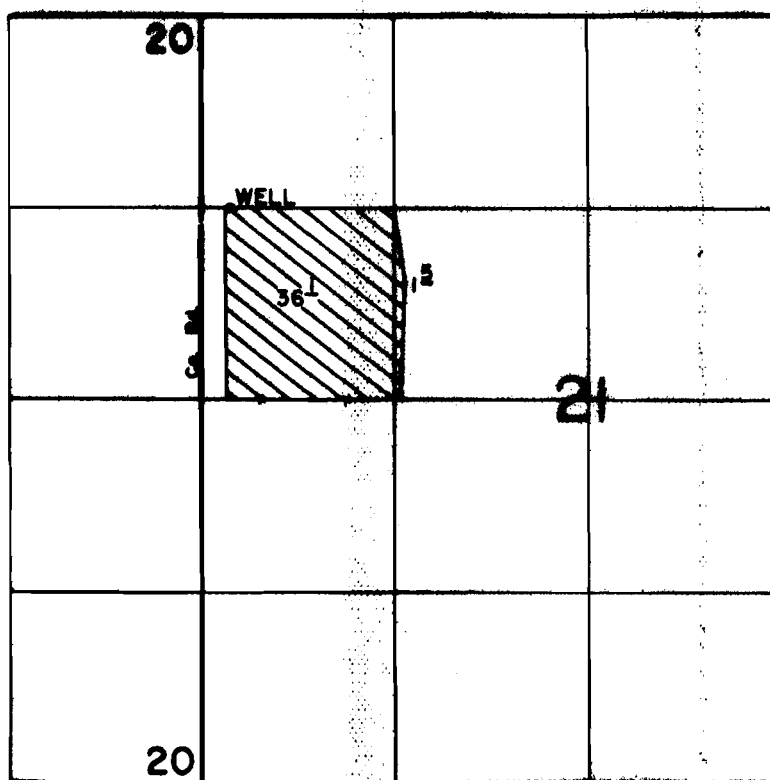

WELL LOC: 1320' N. & 190' E. FROM W 1/4 CORNER SECTION 21

SCALE: 1" = 1320'

FINAL PROOF SURVEY
UNDERApplication No. G-10075 Permit No. G-9168
IN NAME OF**RONALD D. & SUZANNE E. JOHNSON**

Surveyed JULY 25, 1989, by B.W. BISHOP