




T. 27 S., R. 18 E., W.M.

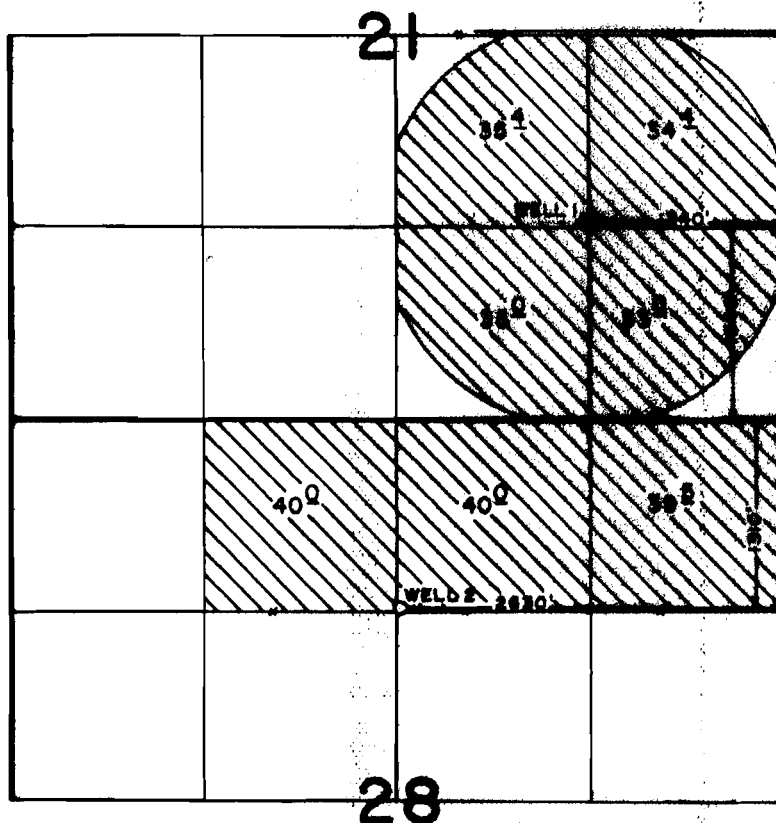

SCALE: 1" = 1320'

FINAL PROOF SURVEY
UNDER

Application No. G-10125 Permit No. G-9202...
IN NAME OF

D.V.A.

Surveyed JULY 20 1989, by B. W. BISHOP