


T.14S., R.12E., W.M.

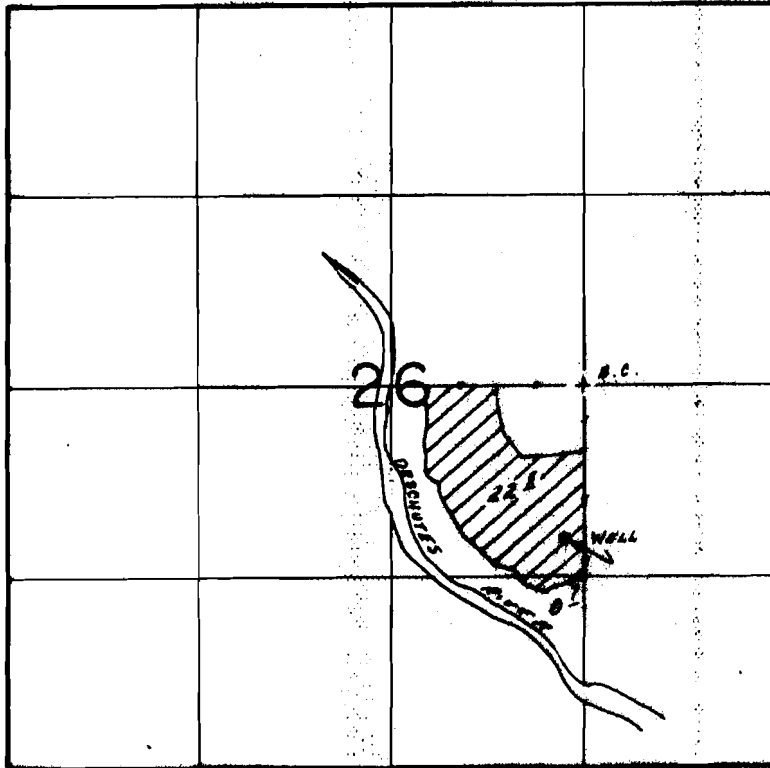

WELL LOC.: 1060'S. $\frac{1}{2}$ 130' W. FROM NE COR. NW $^{\circ}$ SE $^{\circ}$ SEC. 26.

SCALE: 1" = 1320'

FINAL PROOF SURVEY
UNDER

Application No. G:10233. Permit No. G:9373.....
IN NAME OF

Cont. 64018

THOMAS E. & PHOEBE L. BALLARD

Surveyed Apr. 27.... 19.88., by B.W. BISHOP.....

RECEIVED

DATE 2-28-90
WATER MASTER DISTRICT #11
BY [Signature]

G 9373

11/15/88
P.S. 11-1988