


T. 38 S., R. 3 W., W. M.

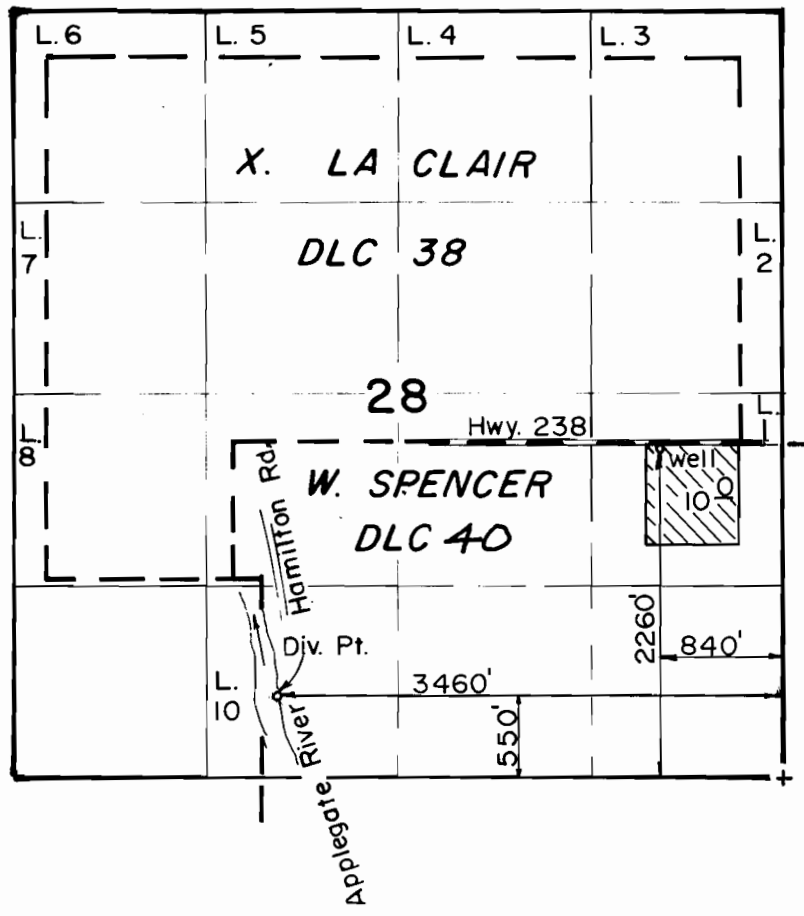

Scale:  
1" = 1320'

**FINAL PROOF SURVEY**  
UNDER

G-10267      G-9410  
Application No. **62336** Permit No. **46488**...  
IN NAME OF

**RICHARD L. SHARP**

Surveyed JAN. 14, 1988, by B. S. JAMES...