


T.26S., R.17E., W.M.

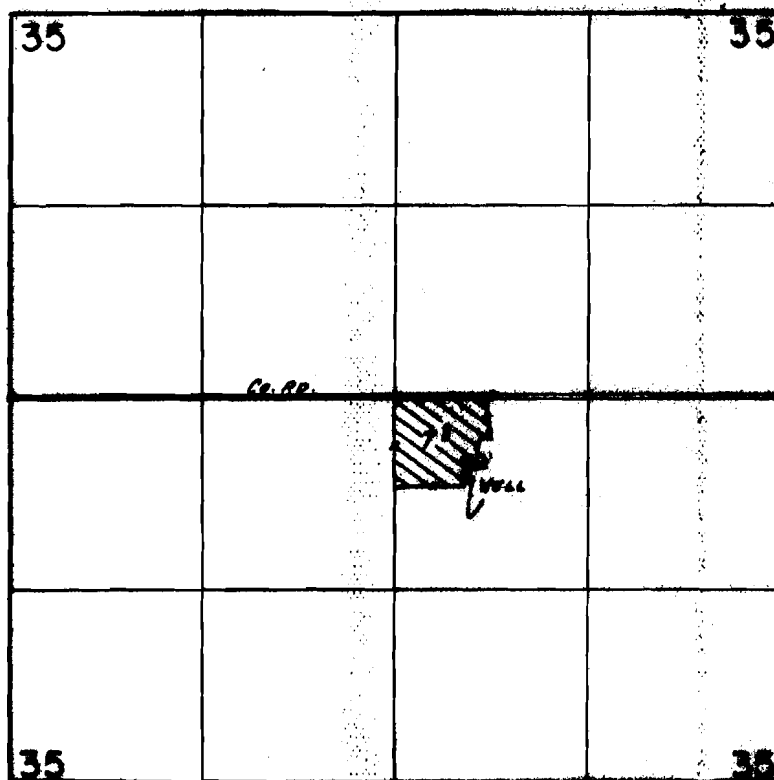

Well Loc.: 2200' N. & 2160' W. FROM SE COR. SEC. 35.

SCALE: 1" = 1320'

FINAL PROOF SURVEY
UNDERApplication No. G-10339 Permit No. G-9357.....
IN NAME OF

LYNN FUS

Surveyed Aug. 30, 1988, by B.W. BISHOP.....