


T. 38 S., R. 7 W., W. M.

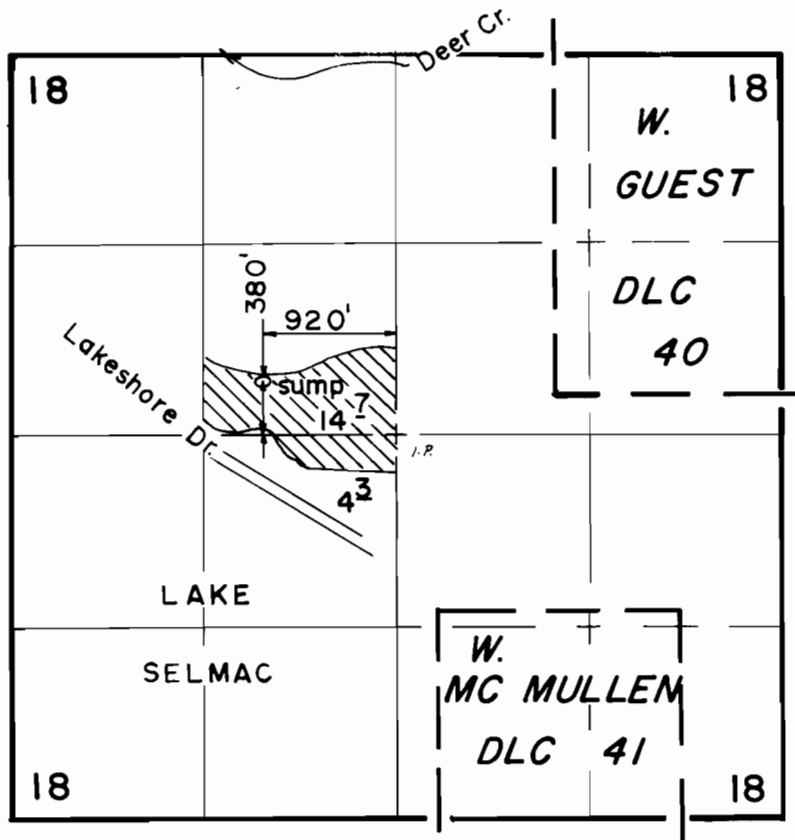

Scale: 1" = 1320'

FINAL PROOF SURVEY UNDER

Application No. G-10372 Permit No. G-9636
IN NAME OF

..... DOUGLAS BELL WATTS

Surveyed JUN. 11. 1986, by B. S. JAMES.