


T. 38 S., R. 7 W., W. M.

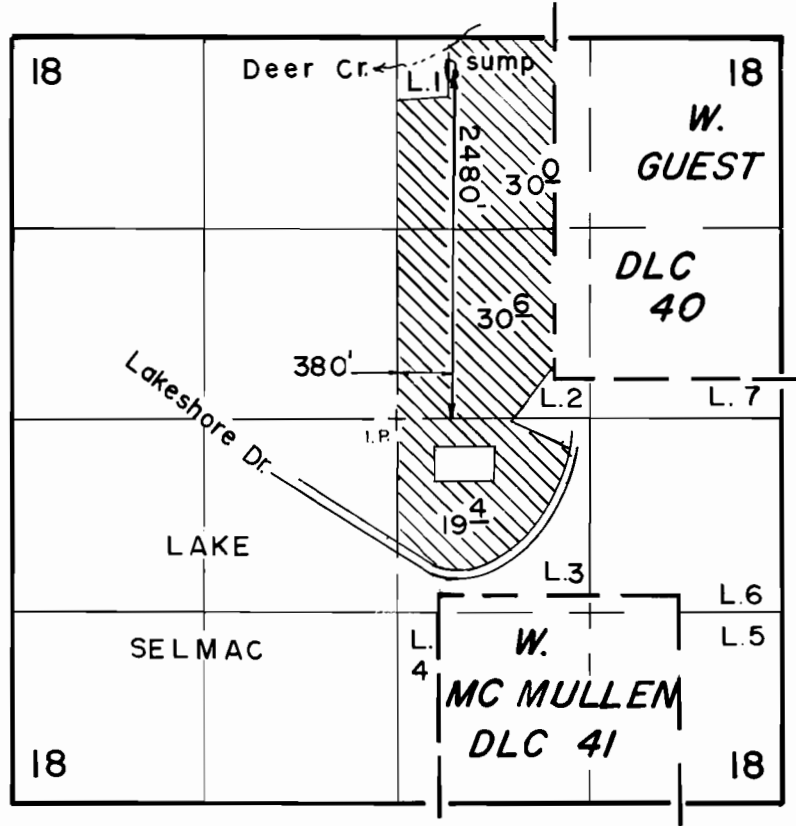

Scale: 1" = 1320'

**FINAL PROOF SURVEY**  
UNDER

Application No. G-10550 Permit No. G-9806  
IN NAME OF

FOUNDATION OF HUMAN UNDERSTANDING

Surveyed JUN. 11. 1986., by B. S. JAMES.