


T. 35 S., R. 6 W., W.M.

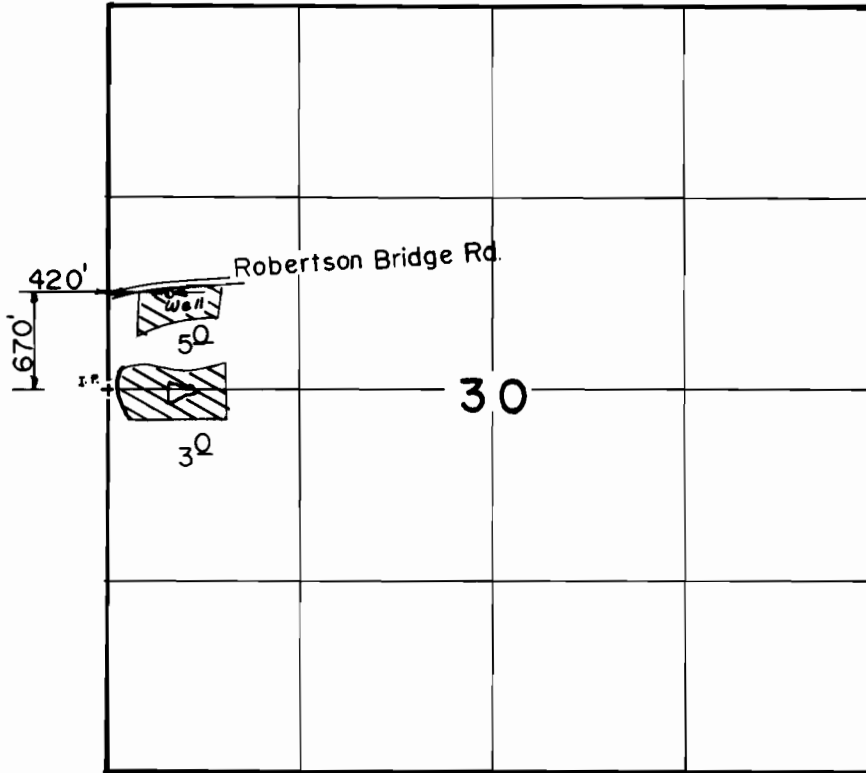

Scale: 1" = 1320'

FINAL PROOF SURVEY
UNDER

Application No. G-10558 Permit No. G-9649....
IN NAME OF

.....CARL.....W.....REINHARDT.....

Surveyed O.C.T....7.... 19.8.7, by .B....S.....JAMES..