



T.6S.,R.IW.&IE.,W.M.

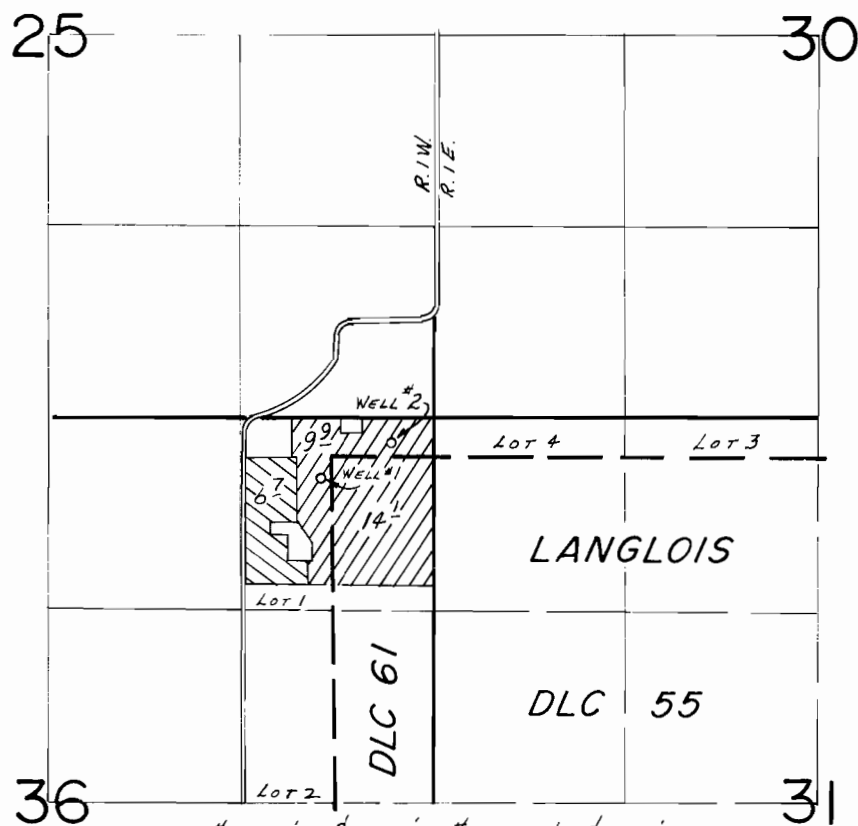

WELLS LOC.: #1-410'S. & 770'W., #2-170'S. & 290'W., BOTH
NE COR. SEC. 36.

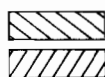

Well No. 1

Well No. 2

SCALE: 1"=1320'

FINAL PROOF SURVEY

UNDER

Application No. G-10594 Permit No. G-9719.....
IN NAME OF

.....MAXIM SAMOILOV.....

Surveyed June 7, 1984, by B.W. BISHOP.....