
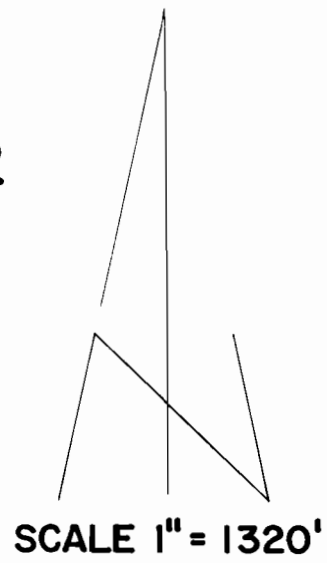


T. 23S., R. 32E., W.M.

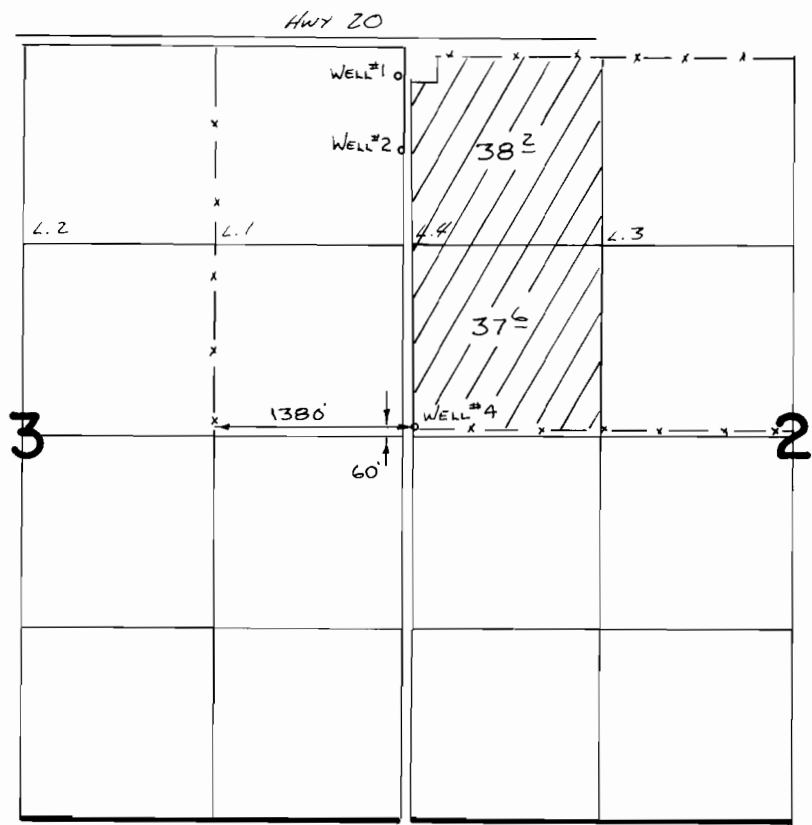

FINAL PROOF SURVEY
UNDER

Application No. **G-10609** Permit No. **G-9525**
IN NAME OF

JETT C. BLACKBURN

Surveyed **5-6** 19**88**, by **J.M. Schmorde**