


T. 8S., R. 2W., W.M.

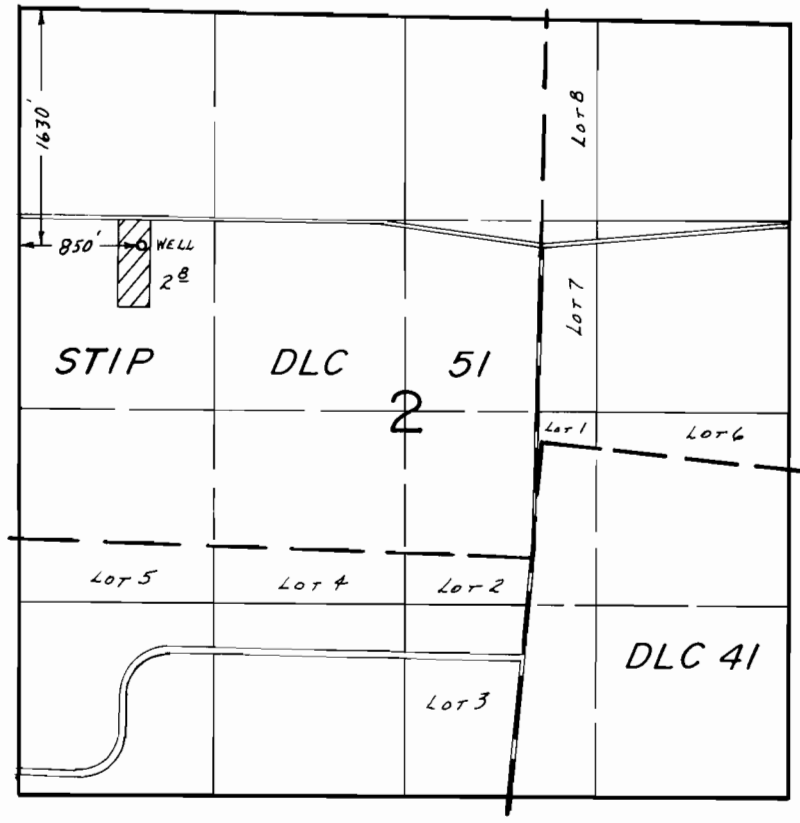

SCALE: 1" = 1320'

FINAL PROOF SURVEY
UNDER

Application No. G-10645 Permit No. G-9756.....
IN NAME OF

HENRY E. WIEDEMAN

Surveyed Nov. 16... 19.84, by B.W. BISHOP.....