


T. 34S., R. 6W. , W.M,

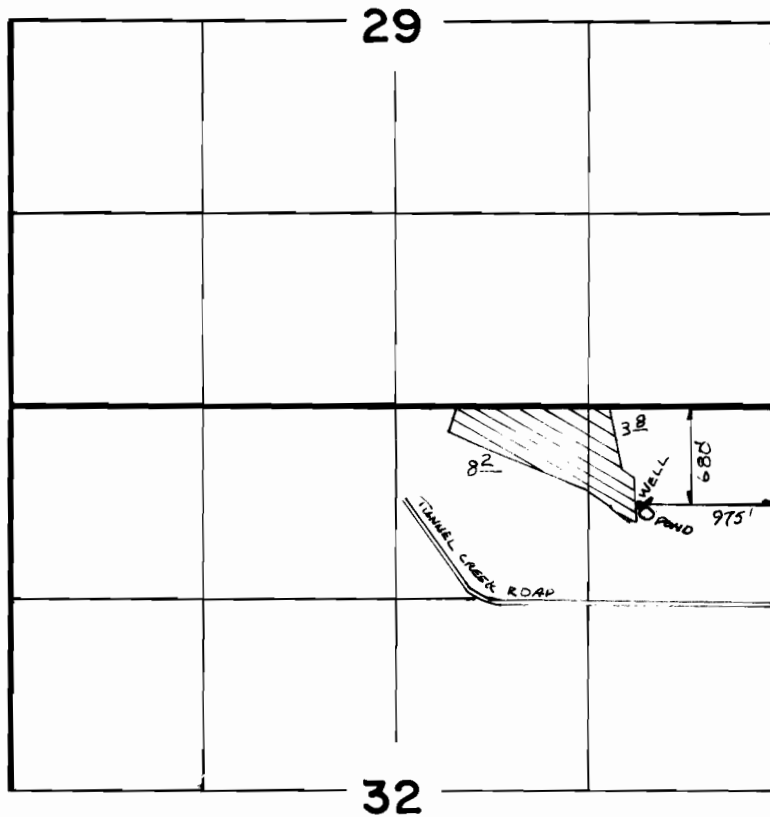

SCALE 1"= 1320'

FINAL PROOF SURVEY
UNDER

Application No. G-10 682 Permit No. G-9 7 85
IN NAME OF

RICHARD P. LOSS

Surveyed SEPT. 11, 1984, by J. WOODROOFE