


T. 5 N. R. 27 E. W.M.

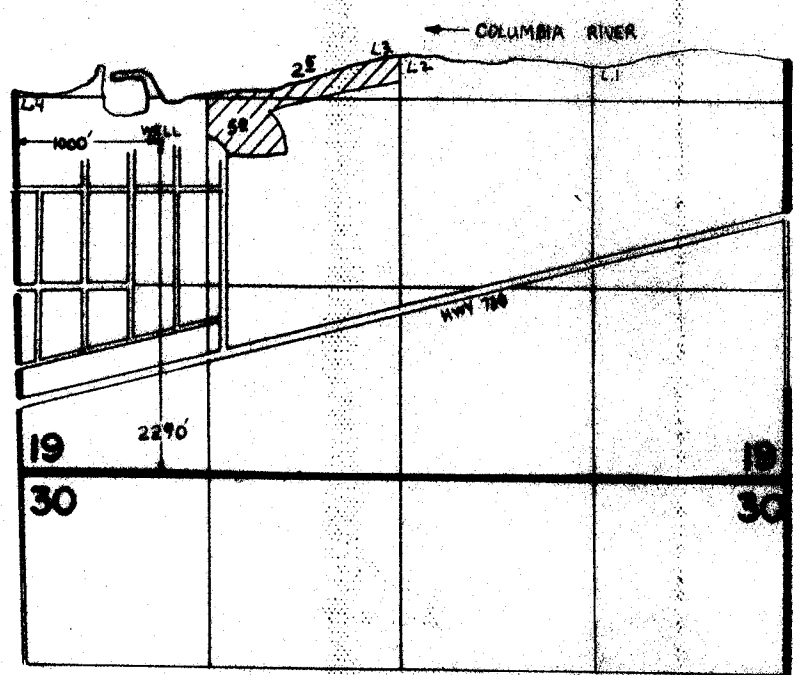

Scale 1"=1320'



FINAL PROOF SURVEY UNDER

Application No. G11016... Permit No. G10387...
IN NAME OF

U.S. ARMY CORPS OF ENGINEERS

Surveyed Jan. 30... 1987... by V. Church