


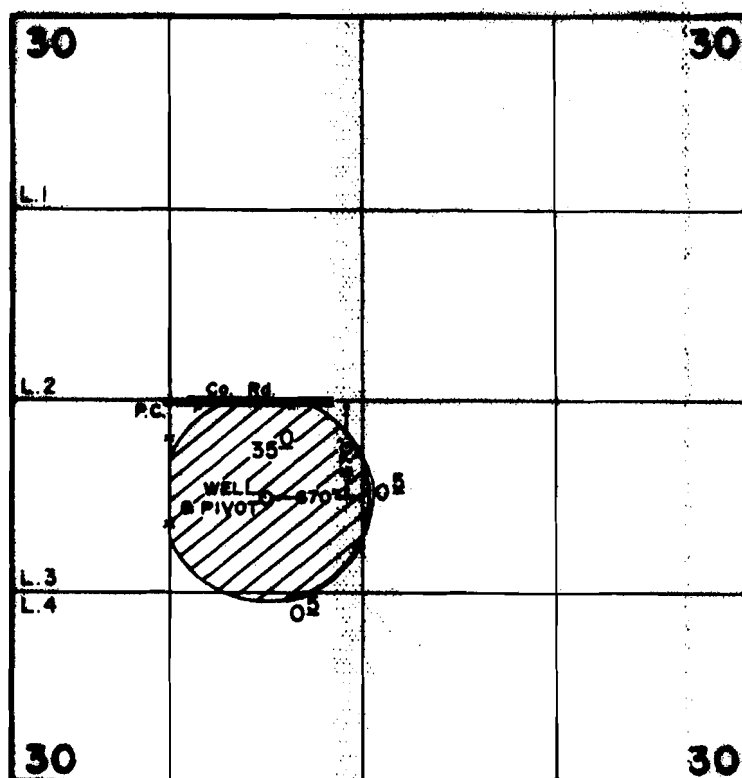

T. 26 S., R. 19 E., W.M.



SCALE: 1" = 1320'

FINAL PROOF SURVEY

UNDER

Application No. G-11061, Permit No. G-10163
IN NAME OF

JOE & ALICE WADE

Surveyed JULY 12, 1989, by L. L. CAREY