


T. 6S., R. 1W., W.M.

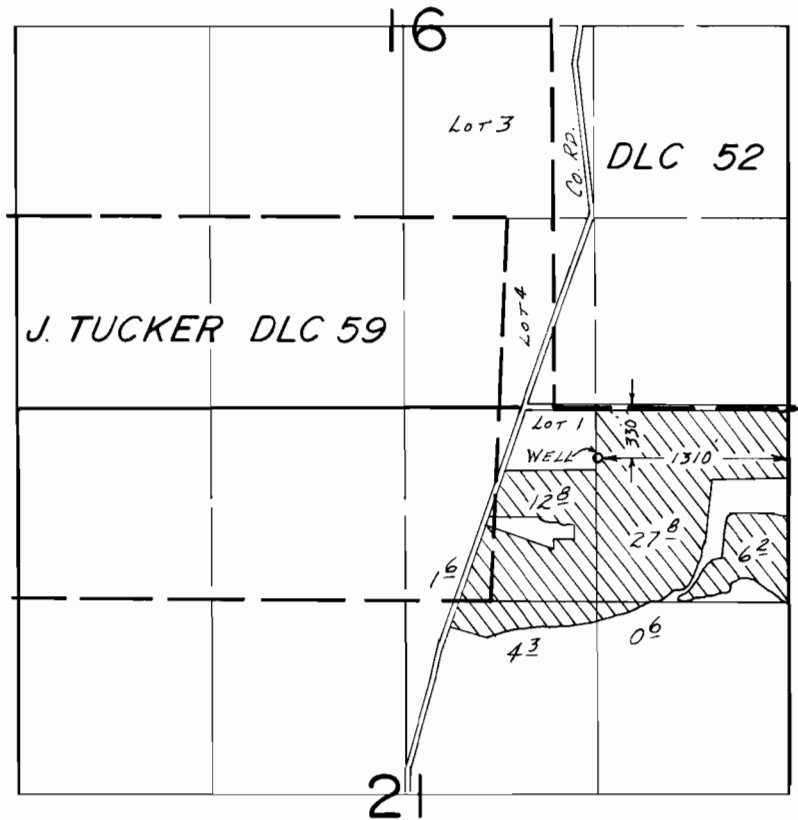

SCALE: 1" = 1320'

**FINAL PROOF SURVEY**  
UNDER

Application No. G-11081. Permit No. G-10301.....  
IN NAME OF

JAMES M. SEVERIN

Surveyed July 23, 1984, by B.W. BISHOP.....